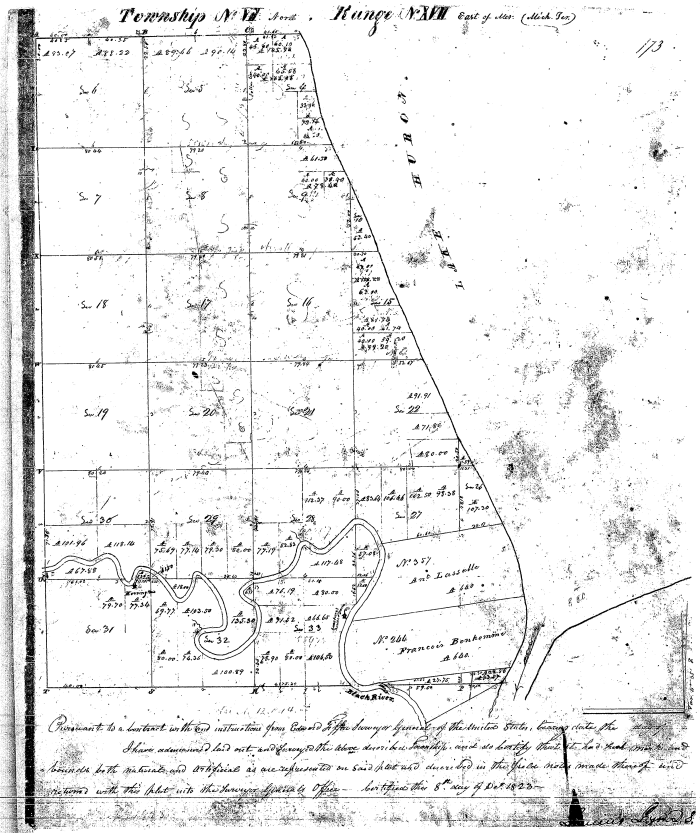

Pursuant to a contract with the said instructions from Edward D. Tracy Surveyor General of the United States, bearing date the
I have examined said plat and survey to the above described township, and do hereby certify that the same is
connected with the natural and artificial objects as represented on said plat and correctly made thereby. And
returned with this plat into this Surveyor General's Office. Certified this 8th day of Dec 1825

173

26-16

26-16