



115

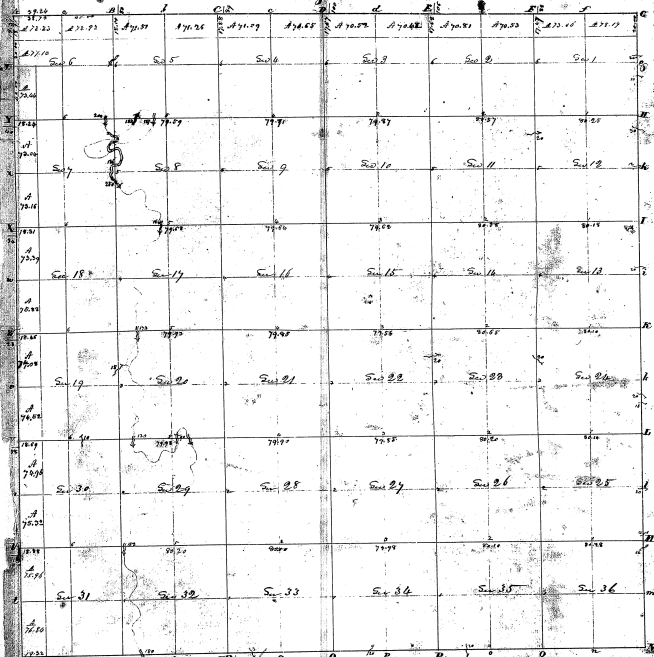

26-14

26-14



Success, Surveyor Genl.