


Township N.V. south, Range N.XI West. (Merid. Co.)

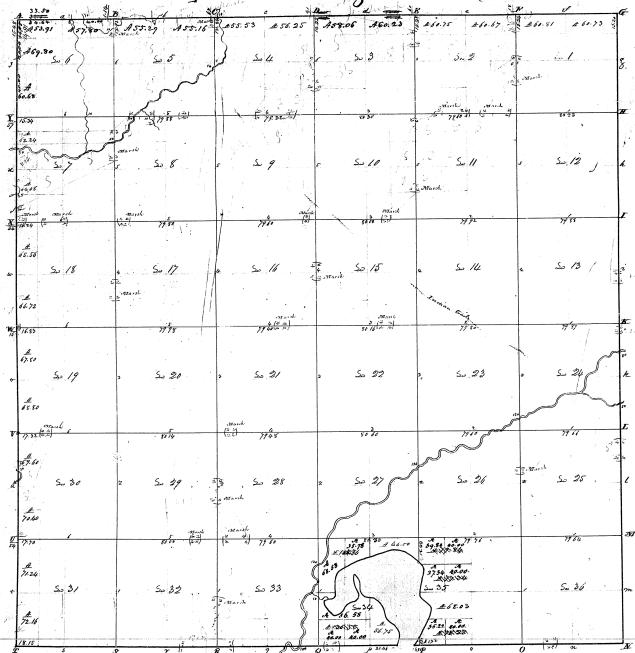

Surveyed in July 1826, by John Mullette D.S.

2-21


Edward Tiffin Sur Gen