2-20

Township No. V south, Range No. XII West Mer. (Mic. Ter.)

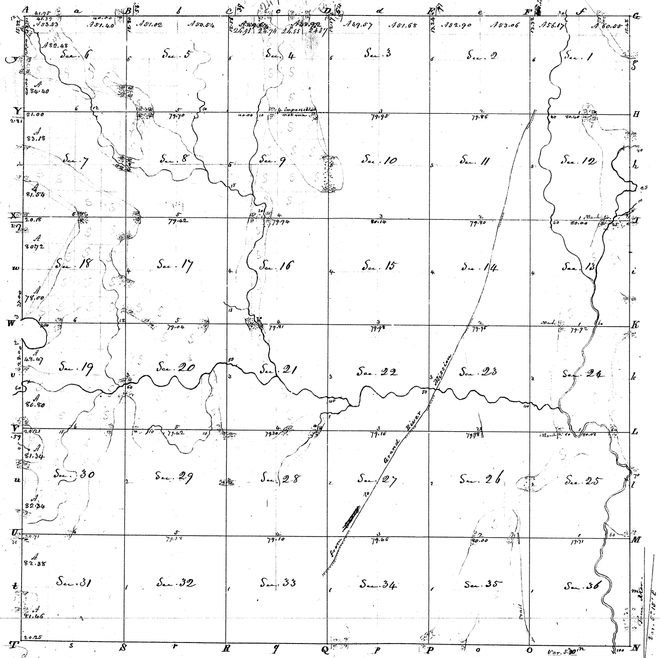

Surveyed in December 1829 by Edward H. Lytle, D. S.

Contents		
Sections	Acres	Hds
N½ NE 1	60	55
S½ " "	80	
N½ NW "	56	17
S½ " "	80	
S½ "	320	
N½ NE 2	53	06
S½ " "	80	
N½ NW "	52	90
S½ " "	80	
S½ "	320	
N½ NE 3	51	68
S½ " "	80	
N½ NW "	49	57
S½ " "	80	
S½ "	320	
N½ NE 4	48	92
S½ " "	80	
N½ NW "	49	67
S½ " "	80	
S½ "	320	
N½ NE 5	50	54
S½ " "	80	
N½ NW "	51	02
S½ " "	80	
S½ "	320	
N½ NE 6	51	40
S½ " "	80	
N½ NW "	53	53
S½ "	82	48
SE "	160	
E½ SW "	80	
W½ " "	84	40
E½ 7	320	
E½ NW "	80	
W½ " "	83	18
E½ SW "	80	
W½ " "	81	54
Sec. 8	640	
9	640	
10	640	
11	640	
12	640	
13	640	
14	640	
15	640	
16	640	
17	640	
E½ 18	320	
E½ NW "	80	
W½ " "	80	72
E½ SW "	80	
W½ " "	78	00
	11.179	33

Content		
Sections	Acre	
E½ 19	320	
E½ NW "	80	
W½ " "	48	47
E½ SW "	80	
W½ " "	80	80
Sec. 20	640	
21	640	
22	640	
[illegible]	640	
24	640	
[illegible]	640	
26	640	
27	640	
[illegible]	640	
29	640	
[illegible] 30	320	
[illegible] NW "	80	
W½ " "	81	34
E½ SW "	80	
W½ " "	82	34
E½ 31	320	
E½ NW "	80	
W½ " "	82	38
E½ SW "	80	
W½ " "	81	46
Sec. 32	640	
33	640	
34	640	
35	640	
36	640	
	11.496	79
	11.179	33
Total	22.676	12

2-20