



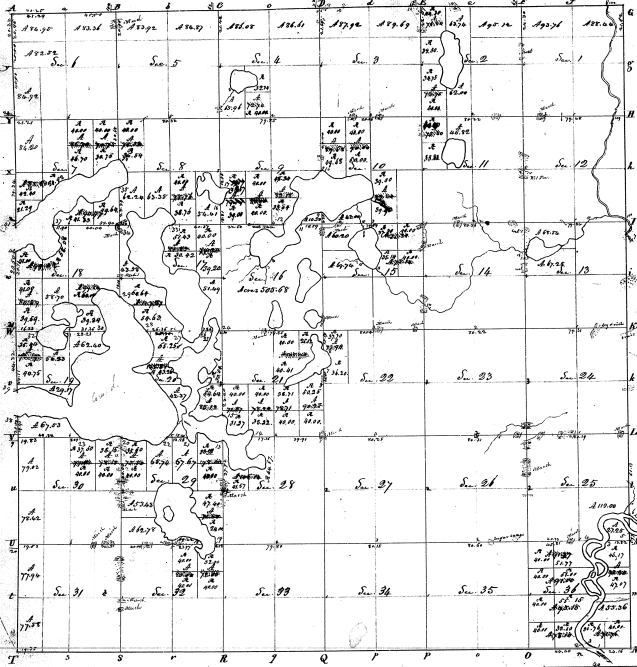


Surveyed in June 1828 - by Calvin Britton, S. & D.



5-2-2

2085 (5)

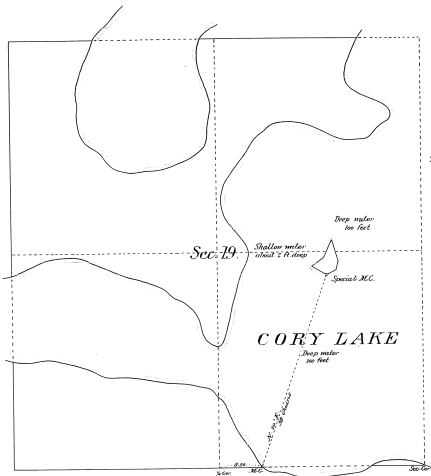

MAP OF ISLAND
IN
CORY LAKE
SECTION 19, T. 6. S. R. 12 W.
MICHIGAN.

Surveyed by O.H. Todd, U.S. Deputy Surveyor
January 15th 1895
Scale 10 chains to an inch.

| Number of Islands | | |
|-------------------|---------------|--------|
| No. | Course | Chains |
| 1. | N. 65° W. | 2.21 |
| 2. | N. 25° E. | 2.76 |
| 3. | S. 22° 30' E. | 2.85 |
| 4. | S. 12° E. | 2.10 |
| 5. | S. 10° 30' W. | 2.79 |
| 6. | S. 67° W. | 1.75 |

AREA
143 Acres

By order of the Commissioner of the General Land Office
this island has been designated as Lot 1. See letter
from Department of the Interior dated Nov. 20, 1890.
Revised this
bearing with accuracy

J. O. Berry
Surveyor

Department of the Interior
General Land Office
Washington D.C. February 12-1895

228

The above map of an island in Cory Lake, in Section No. 19, T. 6. S. R. 12 W. of the Principal Meridian, Michigan, is a correct plot of a survey executed by O.H. Todd, U.S. Deputy Surveyor, in pursuance of instructions from the Commissioner of the General Land Office, bearing date of the 15th day of December 1894, said map is strictly conformable to the field notes thereof which have been examined and approved.

M. Lamoreux
Commissioner and Re-Office Surveyor General for Michigan

RECEIVED AT
GENERAL LAND OFFICE
FEBRUARY 1895

RECEIVED AT
FEBRUARY 1895