# Township N.° VII south, Range N.° XI west of the Miss. Prin.

2-33

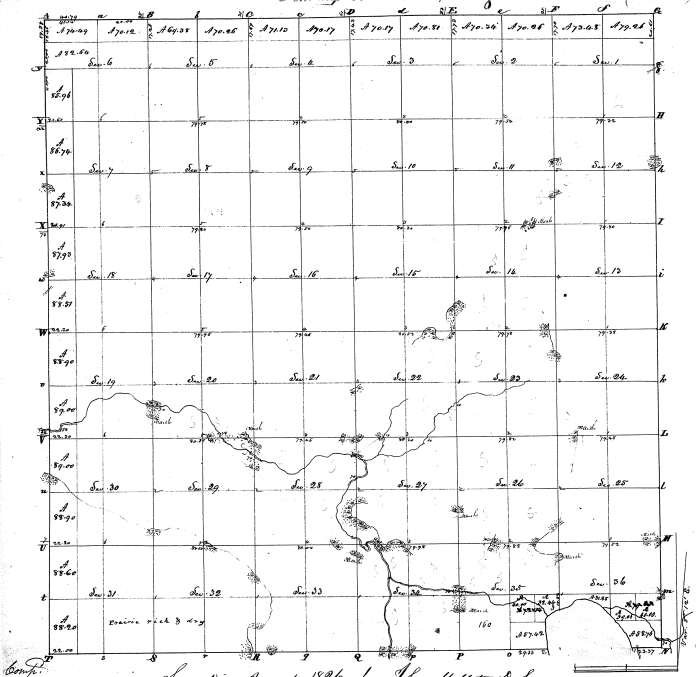


| Sections | Acres | Hund.ths |
|---|---|---|
| N.E. No. 1 | 79 | 24 |
| S.E. " | 80 | |
| N.E. No. W. | 73 | 48 |
| S.E. " | 80 | |
| S.W. " | 328 | |
| N.E. No. 2 | 79 | 24 |
| S.E. " | 80 | |
| N.E. No. W. | 79 | 36 |
| S.E. " | 80 | |
| S.W. " | 320 | |
| N.E. No. 3 | 79 | 81 |
| S.E. " | 80 | |
| N.E. No. W. | 79 | 17 |
| S.E. " | 80 | |
| S.W. " | 320 | |
| N.E. No. 4 | 79 | 17 |
| S.E. " | 80 | |
| N.E. No. W. | 79 | 13 |
| S.E. " | 80 | |
| S.W. " | 320 | |
| N.E. No. 5 | 79 | 24 |
| S.E. " | 80 | |
| N.E. No. W. | 69 | 28 |
| S.E. " | 80 | |
| S.W. " | 320 | |
| N.E. No. 6 | 79 | 12 |
| S.E. " | 80 | |
| N.E. No. W. | 74 | 49 |
| S.E. " | 82 | 64 |
| S.E. " | 160 | |
| E. half S.W. " | 80 | |
| W.E. " | 15 | 98 |
| Sec. 7 | 320 | |
| E.L. No. W. | 80 | |
| N.E. " | 81 | 76 |
| E.L. S.W. " | 80 | |
| W.E. " | 81 | 24 |
| Sec. 8 | 320 | |
| 9 | 640 | |
| 10 | 640 | |
| 11 | 640 | |
| 12 | 640 | |
| 13 | 640 | |
| 14 | 640 | |
| 15 | 640 | |
| 16 | 640 | |
| 17 | 640 | |
| E.L. 18 | 328 | |
| E.L. No. W. | 80 | |
| W.E. " | 81 | 93 |
| E.L. S.W. " | 80 | |
| W.E. " | 88 | 57 |
| | 11,458 | 99 |

| Sections | Acres | Hund.ths |
|---|---|---|
| E.L. 19 | 328 | |
| E.L. N.W. " | 80 | |
| W.E. " | 88 | 90 |
| E.L. S.W. " | 80 | |
| W.E. " | 88 | 90 |
| Sec. 20 | 640 | |
| 21 | 640 | |
| 22 | 640 | |
| 23 | 640 | |
| 24 | 640 | |
| 25 | 640 | |
| 26 | 640 | |
| 27 | 640 | |
| 28 | 640 | |
| 29 | 640 | |
| E.L. 30 | 328 | |
| E.L. N.W. " | 80 | |
| W.E. " | 89 | — |
| E.L. S.W. " | 80 | |
| W.E. " | 88 | 90 |
| E.L. 31 | 328 | |
| E.L. N.W. " | 80 | |
| W.E. " | 88 | 60 |
| E.L. S.W. " | 80 | |
| W.E. " | 88 | 20 |
| Sec. 32 | 640 | |
| 33 | 640 | |
| 34 | 640 | |
| N.E. 35 | 320 | |
| N.E. S.E. " | 72 | 44 |
| S.E. " | 57 | 42 |
| S.W. " | 160 | |
| N.E. 36 | 320 | |
| N.E. S.E. " | 79 | 08 |
| S.E. " | 81 | 76 |
| E. half S.W. " | 31 | 56 |
| | 11,498 | 19 |
| | 11,458 | 99 |
| Total | 22,957 | 11 |

Surveyed in August 1826 by John Mullett D.S.

Edward Tiffin Surv.r General

2-33