


Township N. VII south, Range N. III west (Mc. Tor.)

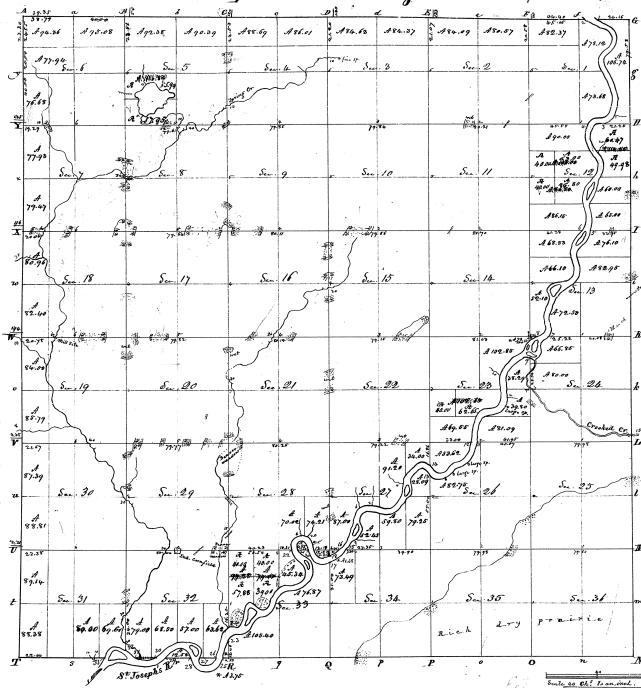

Continued

Surveyed in April 1828 by Calvin Rutens Del.

23 ✓

10

2-12

Bound		Bound	
Acres	Value	Acres	Value

Continued



Original.

2-37

DIAGRAM of a former LAKEBED
 IN SEC. 5, TOWNSHIP 7 SOUTH, RANGE 12 WEST,
 IN THE STATE OF MICHIGAN.


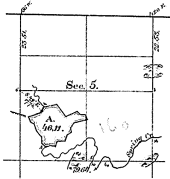

Department of the Interior
 General Land Office

July 22, 1875.

The above diagram of a former Lakebed in Sec. 5, Township 7 South, Range 12 West of the Michigan Meridian, in the State of Michigan, has been constructed from the field notes on file in this office and area calculated in pursuance of the act of Congress, approved 22^d of January 1853.

J. S. Mearns
 Commissioner


U. S. Office Surveyor General of Michigan.

Township N^o 7 S. Range N^o 12 W.
 Lands in St. Joseph River.

Mer. Mich.

2-37

(9)
 2
 1
 2

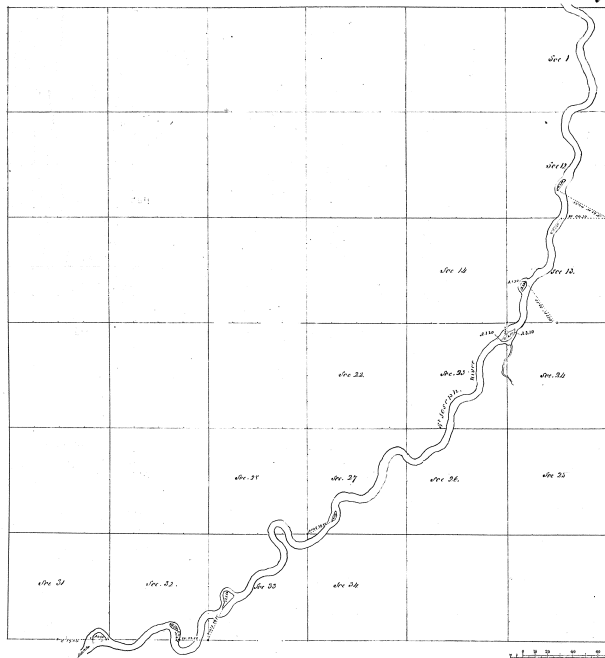

Boundaries of

Pat.	Patress	(1812)	Pat.	Patress	(1812)	Pat.	Patress	(1812)

Total number of Acres 2329

Survey designed.	By Whom Surveyed	Date of Contract	Amount of Survey Acres 25 1/2	When Surveyed	When Claimed in the Court (month year)
Township lines Mandates Additions.	And. Beardslee & Co.	Oct. 11. 1811	2,326.70	2. 1816	

The above Map of Township N^o 7 South of Range N^o 12 West of the Principal Meridian Michigan is a plat of portions in the full view of the survey thereof on file in this Office, which have been examined and approved.

Surveyor General's Office,
 Detroit (1816)

Sacres Lynde, Sec^y Genl