



26-1

26-1

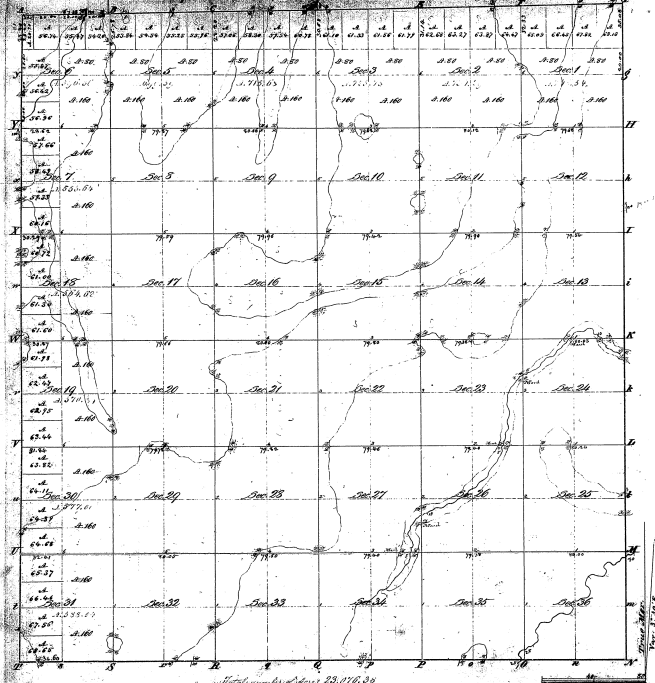



C. Cassin made