


Township N° 11 N, Range N° 12 E Mer Mich.

111  
25-35  
111

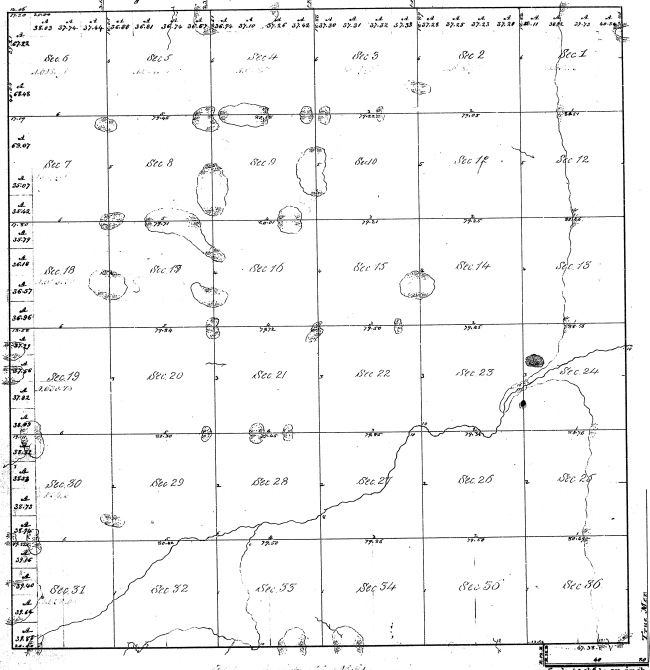

The above Map of Township N° 11 N, Range N° 12 E, Mer. (Sec. 1 to 36) is truly conformable to the full notes of the survey thereof, on file in the Office, which have been examined and approved.  
 Surveyor General's Office  
 Vincennes, Mar 30 1835  
 M. J. Williams  
 Secy.