Township No. 11 N Range No. 13 E Mer. Mich.

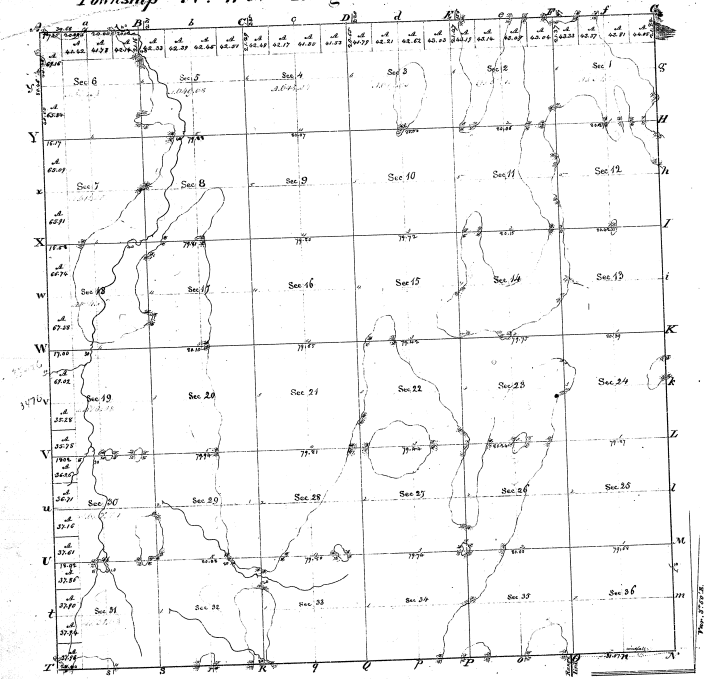

Surveys designated	By whom surveyed	Date of Contract	Amt. of Survey	When surveyed	When Sec. Fr. & Co. in Surv. Field Ack.
Town Lines	Henry Baker	25th Feb. 1833	24. 01. 35	1st. of 1834	2d. of 1834
Subdivisions	Wm. A. Burt	25. Nov. 1833	39. 72. 60	6. of 1834	1. of 1835

The above Map of Township No. 11 North, of Range No. 13 East of the Meridian, Michigan Territory, is strictly conformable to the Field Notes of the Survey thereof on file in this Office, which have been examined & approved.

Surveyor General's Office, Cincinnati, Mar. 30. 1835 } M. T. Williams Surv. Genl.

25-36

25-36