Township N.o 12 N Range N.o 14 E Mer. Mich.

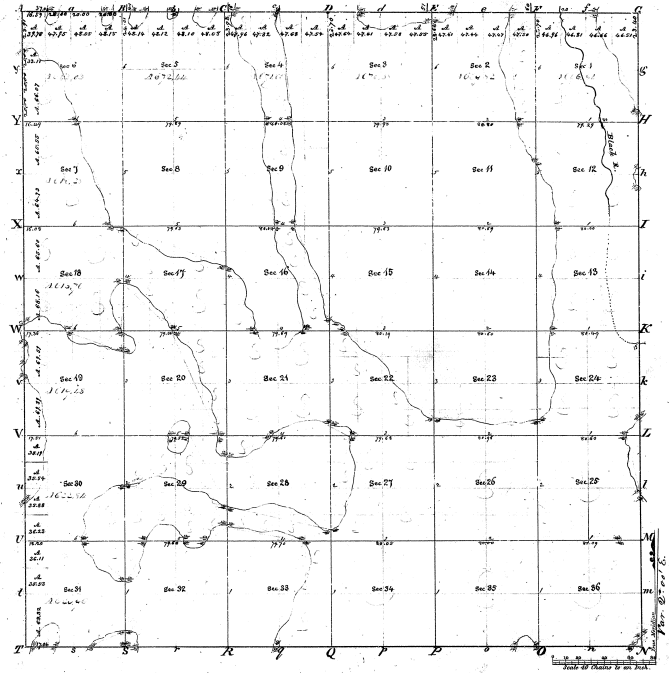

Meanders of			
Point	Courses	Ch^s	Point

25-31

Total number of Acres 23036.45

Surveys Designated	By Whom Surveyed	Date of Contract	Amount of Surveys	When Surveyed	Whether Fair and Ag.^d in the Sur. Gen.^l Off.^e
Subdivision.	N. Carrefield	11. Aug.^t 1834	21. 04. 67	4.^th Oct.^r 1834	1.^st Dec.^r 1835
Township lines	Harvey Burke	23 Aug.^t 1833	2. 01. 85	21.^st Nov.^r 1834	2.^nd Dec.^r 1834

The above Map of Township N.o 12 North of Range N.o 14 East of the Principal Meridian, Mich. is strictly conformable to the field notes of the surveys thereof on file in this Office, and has been examined and approved

Surveyor Generals Office:
Cincinnati Nov.^r 9.^th 1835

M.^r J. Williams
Surv.^r Gen.^l