Township No. 13 N., Range No. 12 E., Mer. Mich.

25-24

114

25-24

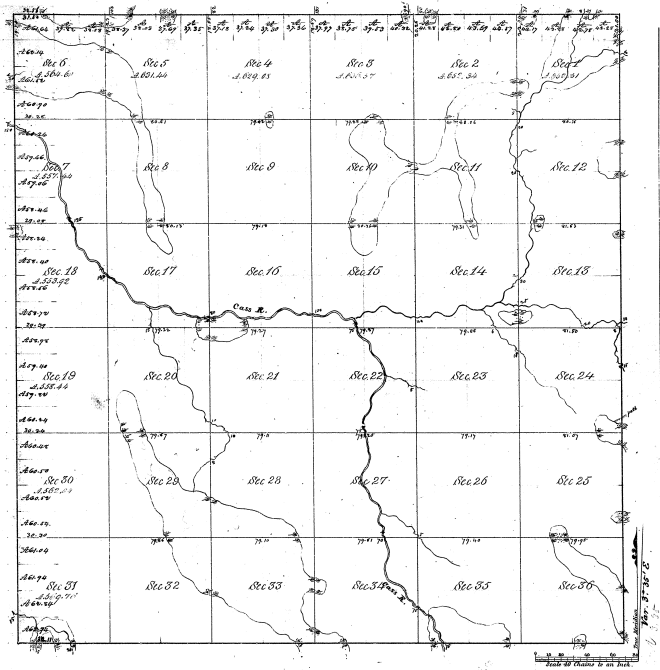

Total number of Acres 22,368.14

Surveys Designated	By Whom Surveyed	Date of Contract	Amount of Surveys	When Surveyed	When plats for and rec'd in the Sur. Gen'l Office
Subdivision.	Jehiel Cone,	11 Sept. 1834	21 Oct. 76	4 qr. 1834	1 qr. 1835
township lines.	Henry Barnes	20 Nov. 1835	23.65.87	3 qr. 1834	3 qr. "

The above Map of Township No. 13 North, of Range No. 12 East of the Principal Meridian, Mich. Ter. is strictly conformable to the field notes of the surveys thereof on file in this Office, which have been examined and approved

Surveyor Generals Office, Detroit: Mich Dec 30. 1835

M. T. Williams
Sur. Gen.l

6½