


Township N^o 14. N. Range N^o 15 E Mer. Mich.

113.
25-20
25-20

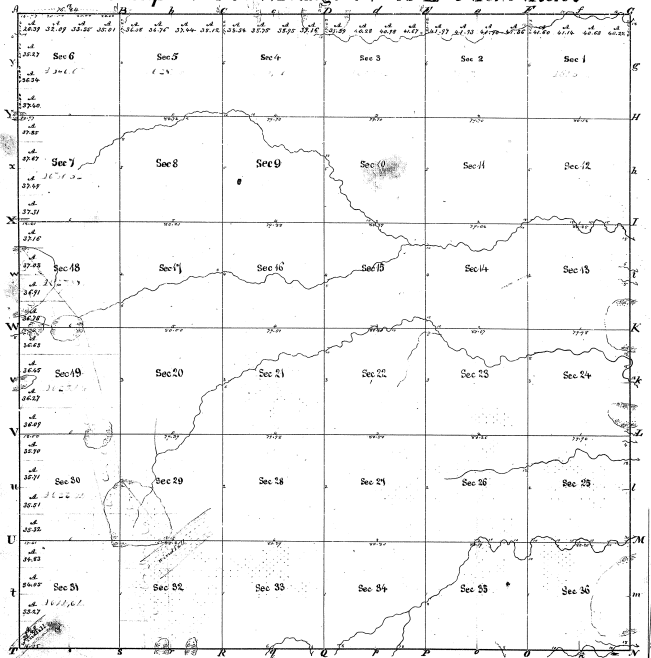


The above plat of Township N^o 14. N. Range N^o 15 E Mer. Mich. (this plat) is filed conformable to the full rates of highway thereof on file in this office which have been examined and approved by the County Clerk of
 M. T. Williams
 Recorder
 Cincinnati, Nov. 20, 1835