


Township N^o 39. N. Range N^o 17. W.

Mer. Mich.

Revised map of March, 1911

46-18

46-18

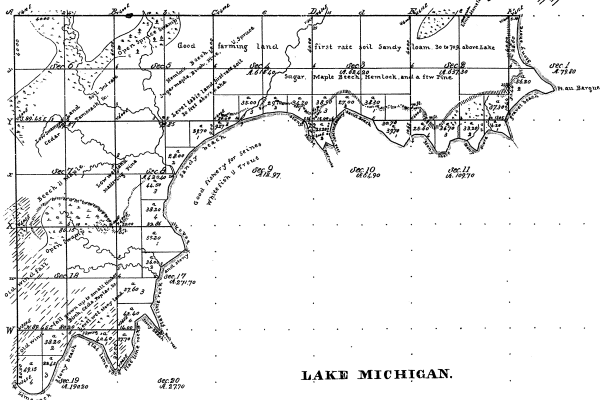

LAKE MICHIGAN.

DEPARTMENT OF THE INTERIOR,
GENERAL LAND OFFICE,

Washington, D. C. *March 17, 1911*
I hereby certify that this plan or map is a true and literal exemplification of the township plat of survey to which it purports to relate, now on file in this office.

Rogers
Commissioner.

V. 163 2

Total number of acres 2,617.97

| Survey designated | By whom surveyed | Date of finished | Amount of land in M. Ch. Sec. | Area surveyed | When changed in the Govt. land |
|-------------------|------------------|------------------|-------------------------------|----------------|--------------------------------|
| Subdivision | A. Montgomery | Dec. 25, 1858 | 24.06 | 7.6 | 314 ac. 11/2 |

This plan or map of Township N^o 39 North of Range N^o 17 West of the Principal Meridian, Michigan is hereby certified to be a true and literal exemplification of the survey showing on file in this office, which have been examined and approved.

Lucius Lyon, Asst. Com.
Subst. March 16, 1911