Township N.o 41 N. Range N.o 15 W. Mer. Mich.

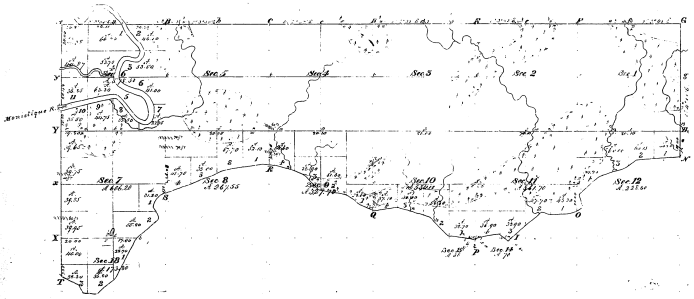

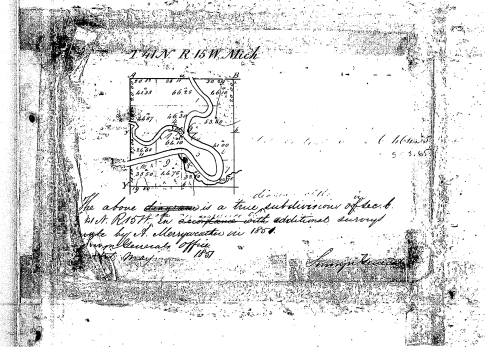

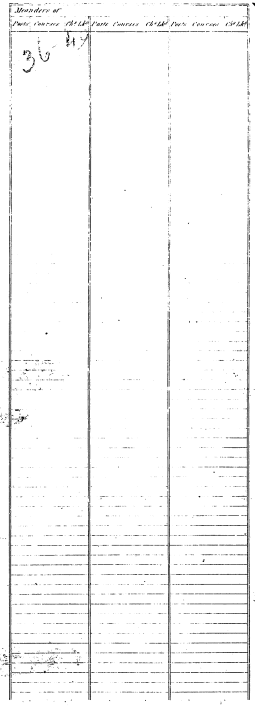

36-40

Total number of Acres 60 /94 70

Surveys Designated.	By Whom Surveyed.	Date of Contract.	Amount of Surveying		When Surveyed.	When Returned to the Surveyor Gen.l Office
			M.	Chs	Lks	
Township Lines						
Subdivisions	Julius Blunk	Feb 24 1857	27	25	67	31 Jy 1857

The above Map of Township N.o 41 North of Range N.o 15 West of the Principal Meridian, is strictly conformable to the field notes of the survey thereof on file in this Office, which have been examined and approved.

Surveyor Generals Office, October 2d.o 26.th 1859

Lucius Lyon, Surv.r Gen.l