Township No. 41 N. Range No. 17 W. Mer. Mich.

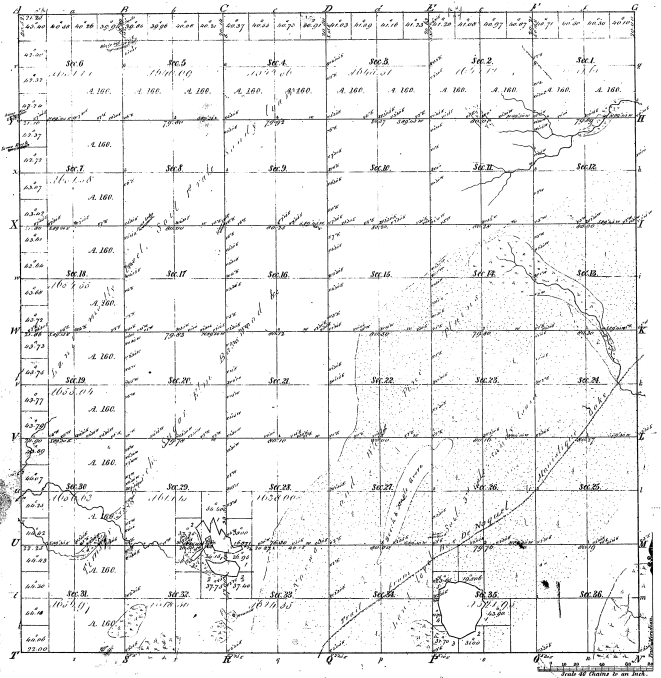

Meanders of							
Posts	Courses	Ch. Lks	Posts	Courses	Ch. Lks	Posts	Courses	Ch. Lks
31	41	43					

37-40

Total number of Acres 22055.75

Surveys Designated	By Whom Surveyed	Date of Contract	Amount of Surveys M. Ch. Lks.	When Surveyed	When 1st Sec. and 36th in the Twp. Gen. Ch. and
Township lines	John Mullett	1st Jan. 1845	24 00 00	2d June 1846	
Subdivisions	A. Mercier	June 8 1846	66 72 91	27th June 1850	

The above Map of Township No. 41 N. North of Range No. 17 West of the Principal Meridian Michigan is strictly conformable to the field notes of the survey thereof on file in this Office, which have been examined and approved.

Surveyor Generals Office
Detroit Dec. 19 1850

Charles Noble
Surv. Genl.