36-34

Township No. 42 N. Range No. 14 W. Mer. Mich

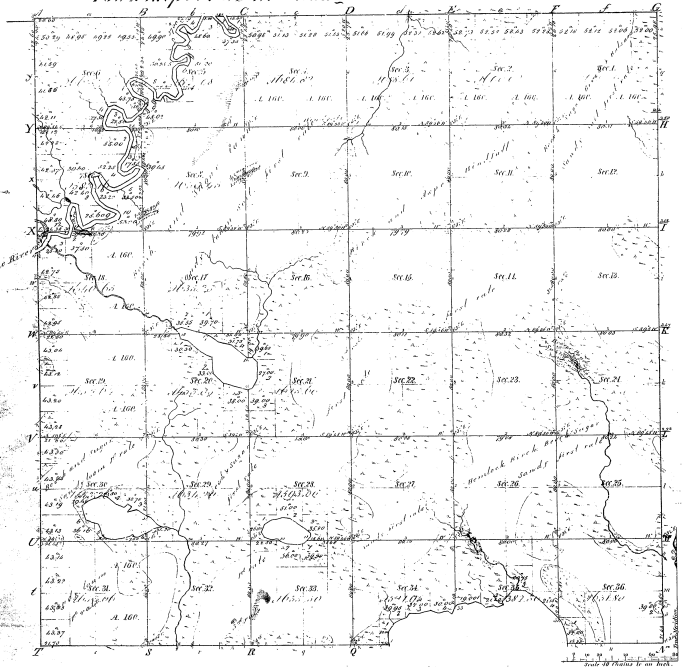

Meanders of								
Poste	Courses	Ch.s Lk.s	Poste	Courses	Ch.s Lk.s	Poste	Courses	Ch.s Lk.s
36-34								

Total number of Acres 22466.00

Surveys Designated	By Whom Surveyed	Date of Contract	Journal of Surveys	When Surveyed	When Sec. and Ch.s on the Sur. Gen.l Ass.t
Subdivisions	A. Merryweather	June 8 1840	80 77	1st 4th 1850	
No. of Subdivisions Rec.d	A. Merryweather			1st 4th 1850	

The above Map of Township No. 42 North of Range No. 14 West of the Principal Meridian Michigan is strictly conformable to the field notes of the survey thereof on file in this Office which have been examined and approved.

Surveyor General's Office.
Detroit July 31. 1851.

Charles Aldrich
Sur. Gen.l