


Township N^o 43 N. Range N^o 15 W.

Mer. Mech.

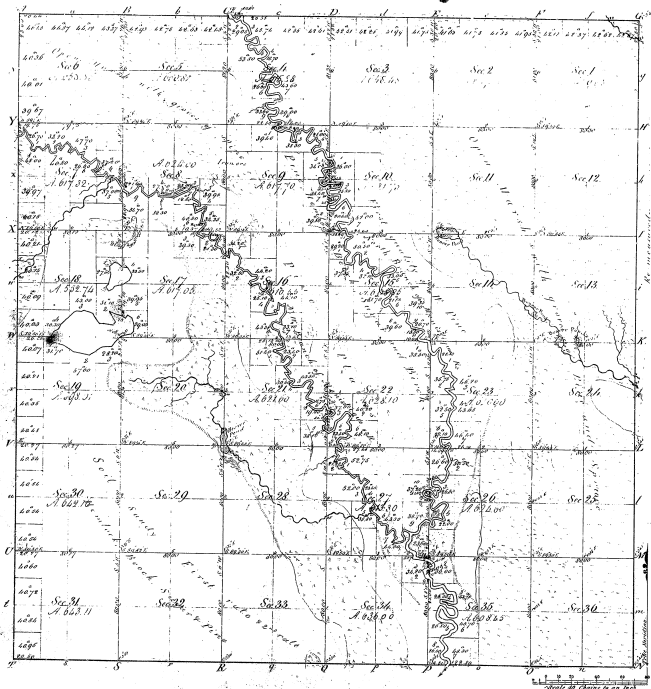

Number of	Acres	Value	Owner	Remarks
1				
2				
Presented
27 March 28 1881

Total number of Acres 27,063.60


The above Map of Township N^o 43 N. Range N^o 15 W. West of the principal Meridian of the Territory is hereby presented to the survey thereof on file in this Office, which have been examined and approved. *George Beardslee, Chief Surveyor*

Wm. H. Beardslee
Sur^{or} Genl.

36-32