


Township, 1° 44' N. Range, 1° 14' W. Mer. Mich

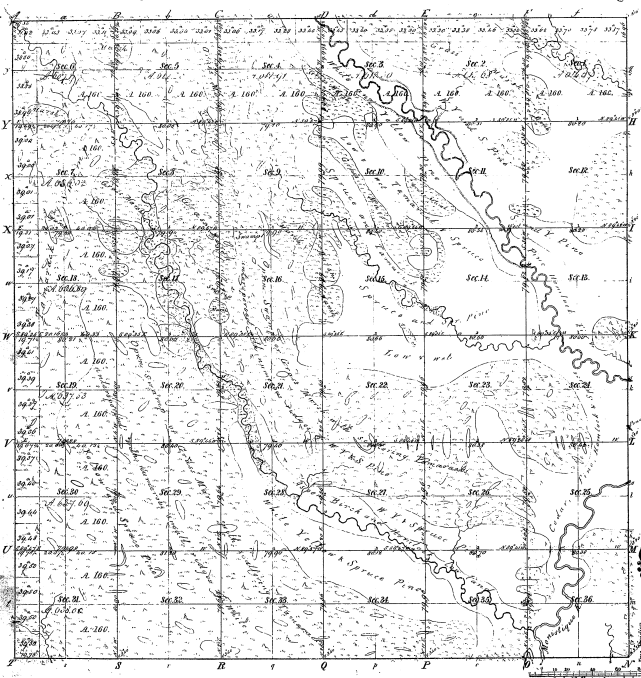

36-26																											

36-26

Total number of Acres, 22,801.00

Survey Designated	By Whom Surveyed	Date of Contract	Amount of Survey	When Surveyed	When made public by the Surveyor
Township line	Geo. A. Gordon	April 1, 1852	36, 32, 29	2-13-1852	
Subdivisions	Geo. A. Gordon	May 12, 1852	29, 63, 27	2-13-1852	

The above Map of Township 1° 44' N., R. 1° 14' W., Mer. Mich. is a correct and true copy of the original, and is hereby approved by the field notes of the survey thereof on file in this Office, which have been examined and approved.

Surveyor General's Office,  
October 26, 11, 1857.

Charles A. Wood,  
Supt. Genl.