



Township 1° 44' N. Range 1° 16' W. Mer. Mich.

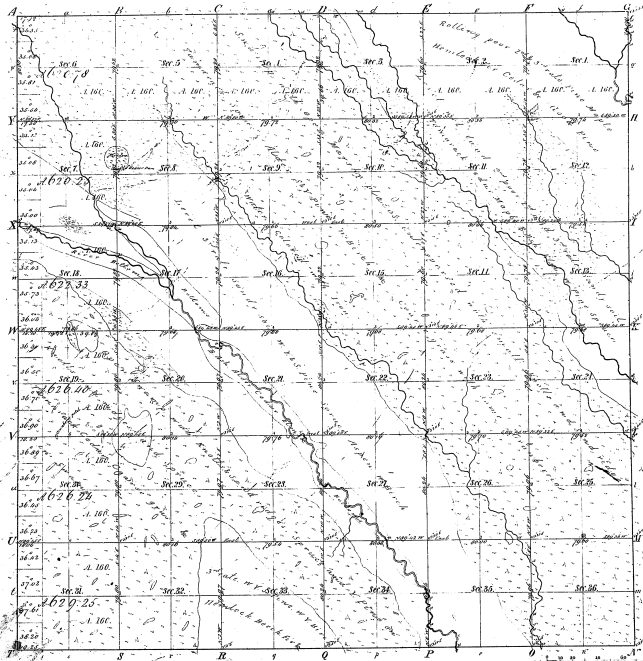

Boundary of  
First Course 1842, 2nd Course 1844, 3rd Course 1846

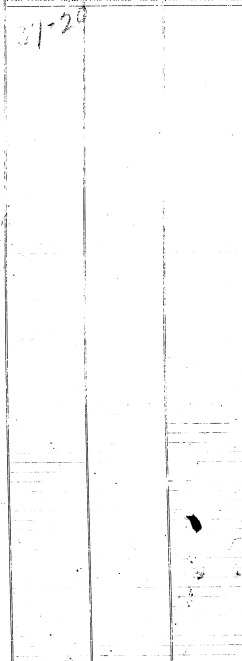

21-20

Total number of Acres 22045.25

Survey Designated	By Whom Executed	Date of Contract	Amount of Survey	When Surveyed	How far east and west in the Section

The above Map of Township 1° 44' North of Range 1° West of the Principal Meridian Michigan is a study copy made by the field notes of the survey thereof on file in this Office, which have been examined and approved.

Surveyor General's Office  
Detroit March 5 1851

Charles B. G. G.  
Super.