Township No. 45 N. Range No. ~~42~~ W. Mer. Mich.

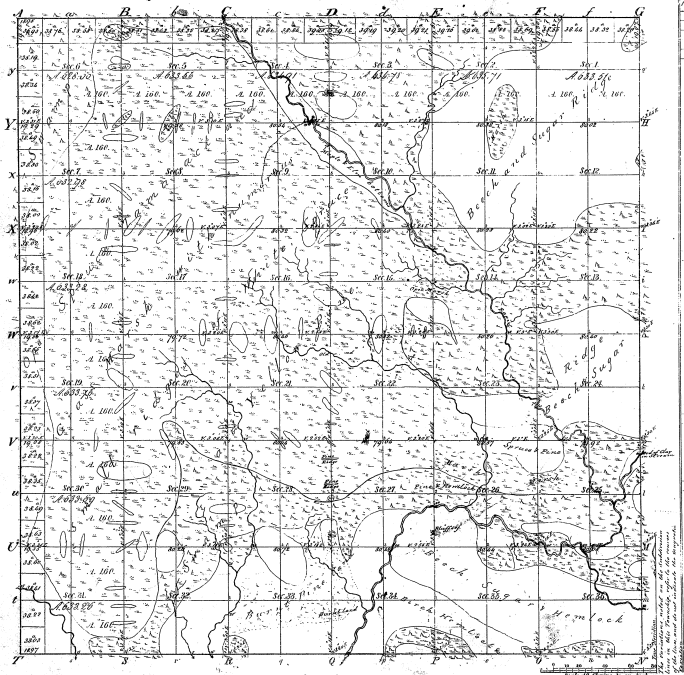

Alexanders et al
Peats Entrance 1874
Peats Entrance 1874
Peats Entrance 1874

36-22

Total number of Acres 22,960.44

Surveys Designated	By Whom Surveyed	Date of Contract	Plotted & Surveys	When Surveyed	When Plat and Field Notes filed in the Surr. Gen'l Office
Subdivision of Sections	Wm. A. Burke	April 1st 1854	11, 12, 22	3rd Quar. 1854	
Meanders of Rivers	Wm. M. Chamberlain	Feby 1st 1855	27, 28	3rd Quar. 1854	

The above Map of Township No 45 North of Range 1st 13 West of the Principal Meridian Michigan is strictly conformable to the field notes of the survey thereof on file in this Office, which have been examined and approved.

Surveyor Generals Office
Detroit Sept 3 1855

Charles Noble
Sur. Gen'l