36-24

Township. No. 45 N. Range. No. 15 W. Mer. Mich.

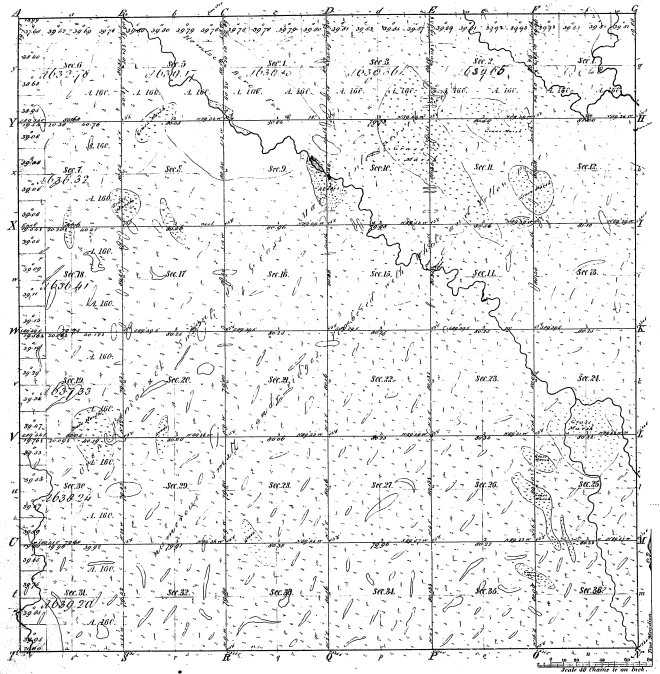

Meanders of					
Posts Courses	Ch.s Lk.s	Posts Courses	Ch.s Lk.s	Posts Courses	Ch.s Lk.s
36-24					

Total number of Acres. 23017.09

Surveys Designated	By Whom Surveyed	Date of Contract	Amount of Surveys	When Surveyed	When p.d for and ch.d in the Int. Gen.l Ass.t
Township Lines	R. A. Burt	April 1st 1841	11. 94. 00	3rd Quar. 1841	
Subdivisions	C. H. Carlton	May 10. 1850	60. 12. 90	3rd Quar. 1850	

The above Map of Township No. 45 North of Range No. 15 West of the Principal Meridian Michigan is strictly conformable to the field notes of the survey thereof on file in this Office, which have been examined and approved.

Surveyor General's Office.
Detroit Feb. 18. 1851

Charles Noble
Sur. Gen.l