


Township N^o 47N Range N^o 14W Mer. Mich.

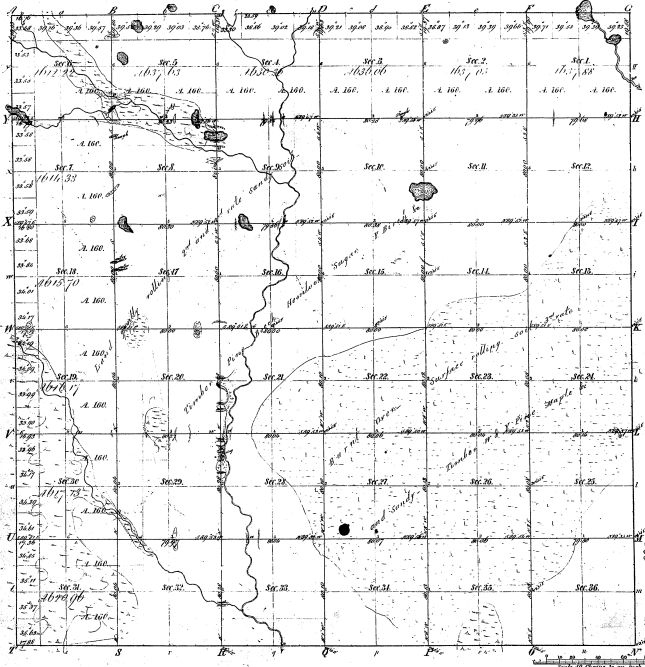

Total number of Acres, 29875.69

Survey designated	By Whom Surveyed	Date of Contract	Amount of Survey	When Surveyed	Reference to the Section 24 Act
Township Survey	William A. Davis	April 9, 1851	36 Secs.	1851	Section 24 Act
Subdivisions	Geo. E. Adams	April 9, 1851	63, 65, 34	1 st Decr 1851	

The above Map of Township N 47 North of Range 14 West of the Meridian of Michigan is a correct representation of the field notes of the survey thereon on file in this office, which have been examined and approved by the Survey General Office.
 Detroit, July 17, 1852
 Geo. W. Allen
 Surveyor General

Number of	Acres	Value	Remarks
36	29875.69		

36-15