Township N.o 47 N. Range N.o 15 W. Mer. Mich.

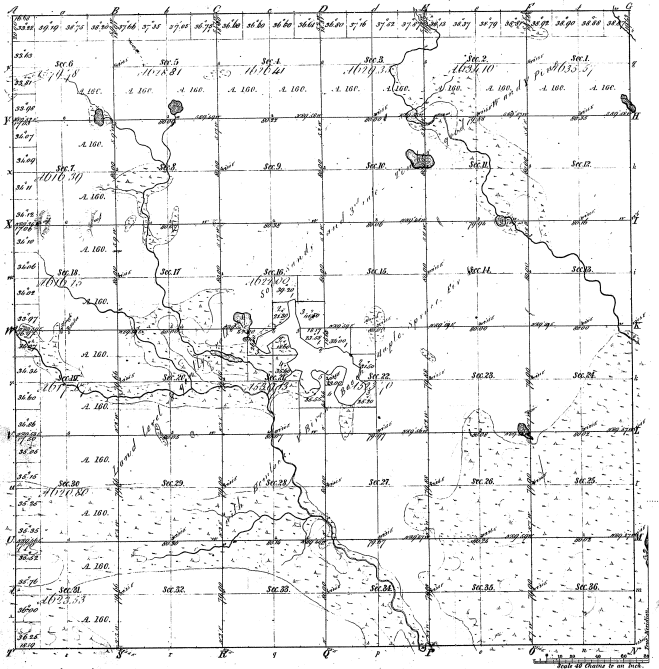

Meanders of					
Poste	Courses	Ch's & L's	Poste	Courses	Ch's & L's	Poste	Courses	Ch's & L's

Meanders 3 miles 56 chains by Lands

Total number of Acres 22703.69

Surveys Designated	By Whom Surveyed	Date of Contract	Amount of Surveys	When Surveyed
Township lines	William A Burt	April 1st 1841	71 72 82	2nd Quar. 1841
Subdivisions	Geo. W. Adair	April 9 1851	63 76 50	2nd Quar. 1851

When 1st Sec and 31st on the Bar'l on N. and W.

The above Map of Township N.o 47 North of Range N.o 15 West of the Principal Meridian Michigan is strictly conformable to the field notes of the survey thereof now on file in this Office and have been examined and approved.

Surveyor Generals Office. Detroit July 19 1852. Charles Noble Surv.r Gen.l

36-16