


Township N. VIII north, Range N. II East Mer. (Mich. Ter.)

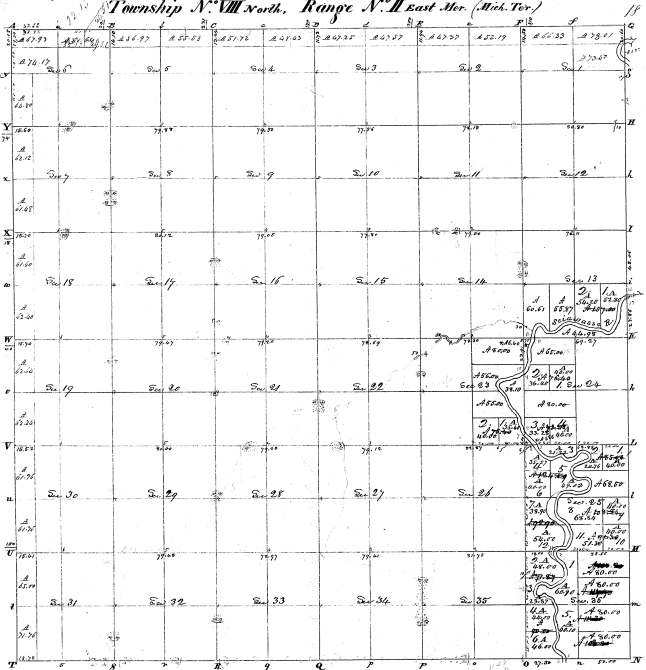



by said surveyor and returned with this plan into the Surveyor General's Office. Certified this day of January 1824

William Brockwell, Secy.

29-10

29-10

Township N. VIII north, Range N. E. East Mer. (Mich. Ter.)

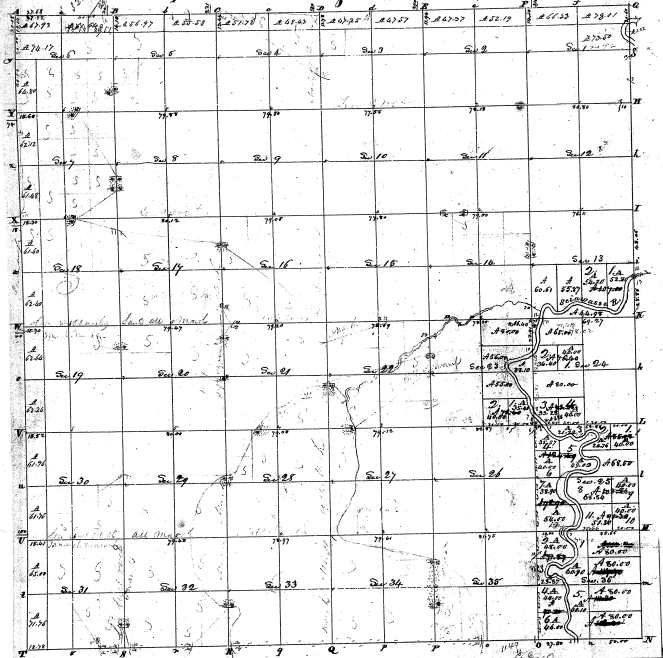

29-10

29-10

Pursuant to a contract with and instructions from Edward J. Barry, General of the United States, bearing date the
 day of
 June aforesaid, laid out and surveyed the above bounded and described tract in the
 north and south both sections and all parts as are represented on the plan and situated in the said State of
 Michigan and returned with the plat into the survey General's Office, bearing the date of January 1836
 William Brockhoff B. S.