


Township N<sup>o</sup> 11 N, Range N<sup>o</sup> 11 E Mer Mich.

111  
25-34  
1111  
25-34

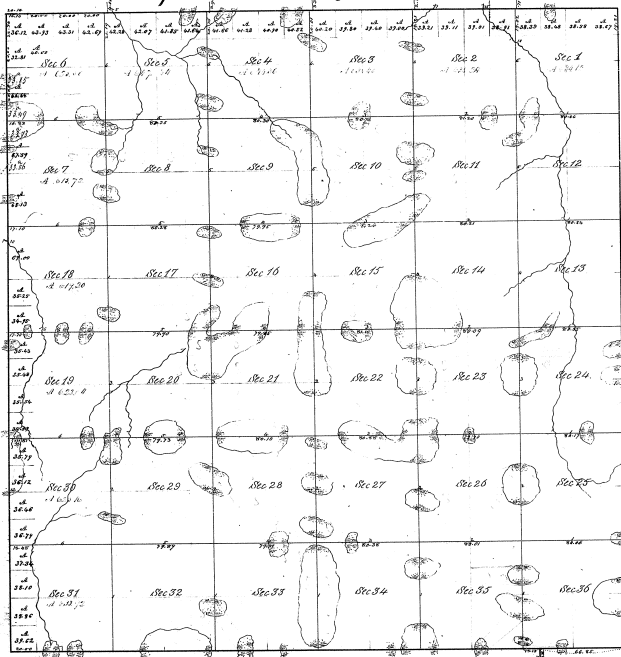



The above Map of Township N. 11 N. Range N. 11 E. Mer. Mich. is hereby confirmed to the full notes of the Survey Genl. on file in this Office which have been examined and approved.

Surveyor General's Office  
Cincinnati, Nov. 26<sup>th</sup> 1835

M. F. Williams  
Sur. Genl.