Township No. 14 N. Range No. 9 E., Mer. Mich.

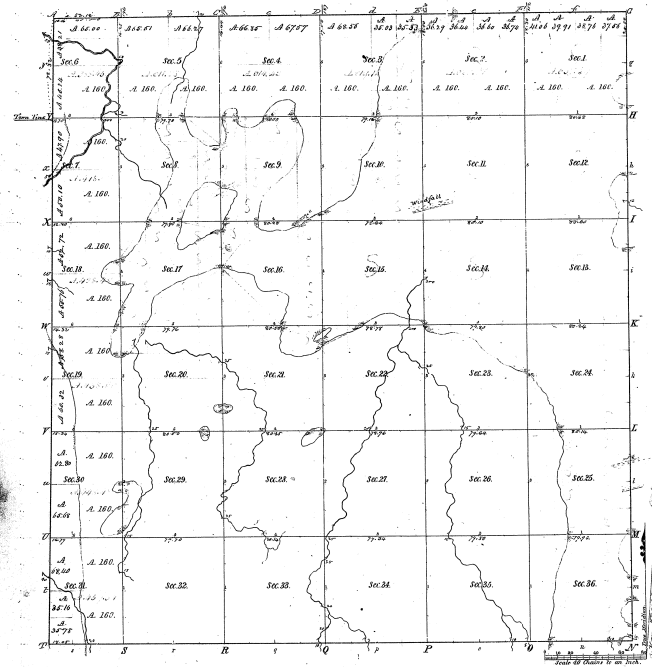

Meanders of	
Path Courses &c.	Path Courses &c.

Total number of Acres. 1,[illegible]

	Surveys Designated	By Whom Surveyed	Date of Contract	Amount of Surveys	When Surveyed	When 1st & 2nd Ser. of the Int. Gen.l was
N.B.S.	Township lines	Stanley Rathbun	20th Nov. 1822	M. Ch. Lks. 7, 35, 00	1st 1825	2nd 1826
	Subdivisions	Charles Baldwin	8th Nov. "	23 - 17 - 42	1st "	2d 1826

The above Map of Township No. 14 N. of Range No. 9 E. of the Principal Meridian (Mich. Ter.) is strictly conformable to the field notes of the survey thereof on file in this office, which have been examined and approved.

Surveyor General's Office,
Cincinnati.

[illegible] Surv. Genl.