Township No. 1 South, Range No. XIII West Mer. (Mic. Ter.)

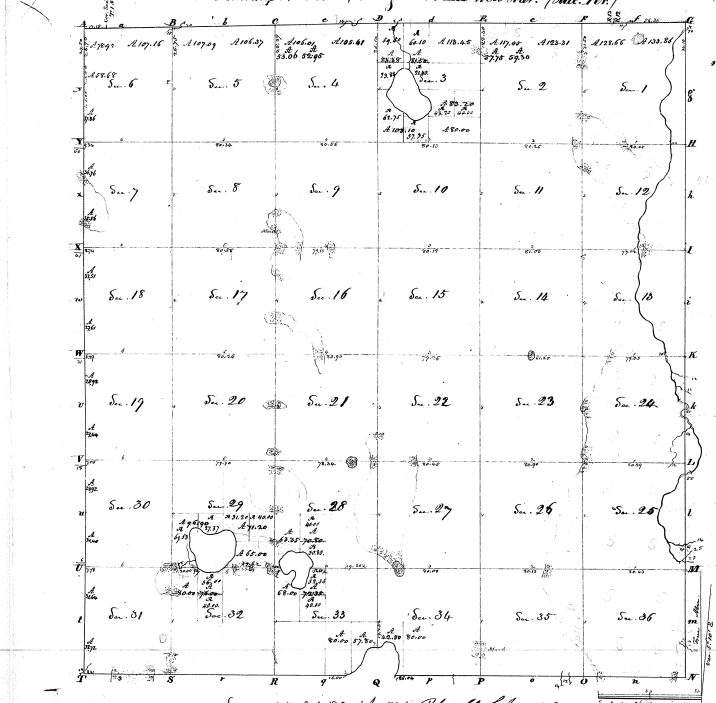

Surveyed in Dec. 1824 & Jan. 1825 by Robert Clark Asst. D. S.

Contents		
Sections	Acres	Hds
NL NE 1	133	84
SL " "	80	
NL NW "	128	66
SL " "	80	
" SW "	320	
NL NE 2	133	31
SL " "	80	
NL NW "	117	05
SL " "	80	
" SW "	320	
NL NE 3	113	63
SL " "	80	
EL NW "	87	58
WL " "	83	38
NL SE "	83	20
SL " "	80	
" SW "	100	10
NL NE 4	105	61
SL " "	80	
NL NW "	106	01
SL " "	80	
" SW "	320	
NL NE 5	106	37
SL " "	80	
NL NW "	107	09
SL " "	80	
" SW "	320	
NL NE 6	107	16
SL " "	80	
NL NW "	78	92
SL " "	58	48
" SE "	160	
EL SW "	80	
WL " "	37	36
EL " 7	320	
EL NW "	80	
WL " "	36	76
EL SW "	80	
WL " "	35	56
Sec. 8	640	
9	640	
10	640	
11	640	
12	640	
13	640	
14	640	
15	640	
16	640	
17	640	
" 18	320	
EL NW "	80	
WL SW "	32	57
EL SW "	80	
WL " "	81	61
	11 483	93

Contents		
Sections	Acres	Hds
EL 19	320	
EL NW "	80	
WL " "	82	92
EL SW "	80	
WL " "	27	66
Sec. 20	640	
21	640	
22	640	
23	640	
24	640	
25	640	
26	640	
27	640	
NL 28	320	
SE "	160	
EL SW "	72	80
WL " "	63	35
NL 29	320	
NL SE "	71	20
SL " "	80	
" SW "	78	20
EL 30	320	
EL NW "	80	
WL " "	25	92
EL SW "	80	
WL " "	34	40
EL 31	320	
EL NW "	80	
WL " "	31	64
EL SW "	80	
WL " "	32	28
NL 32	160	
EL NW "	76	00
WL " "	80	
" SW "	320	
NL 33	160	
EL NW "	72	35
WL " "	69	80
EL SE "	37	80
WL " "	80	00
" SW "	160	
NL 34	320	
SE "	160	
EL SW "	80	
WL " "	42	50
Sec. 35	640	
36	640	
	11 936	26
	11 483	93
Total	23 420	19

2-2