



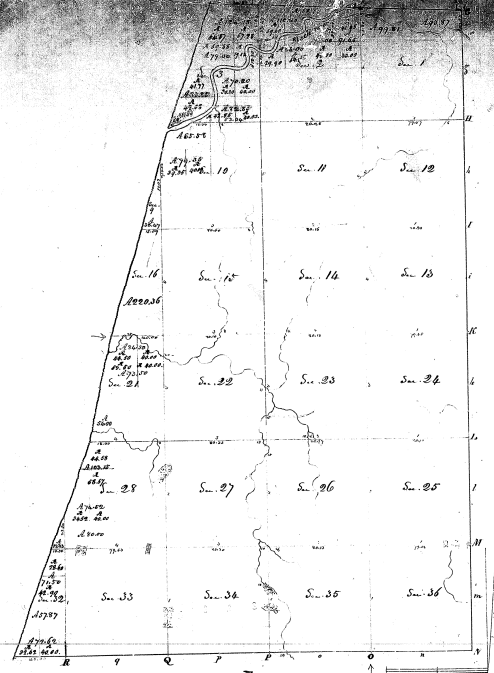


Surveyed in February 1880. by Robert Clark Jr. S.S.