


Township N<sup>o</sup> 1 South, Range N<sup>o</sup> 7 East of the (4th Mer)

34

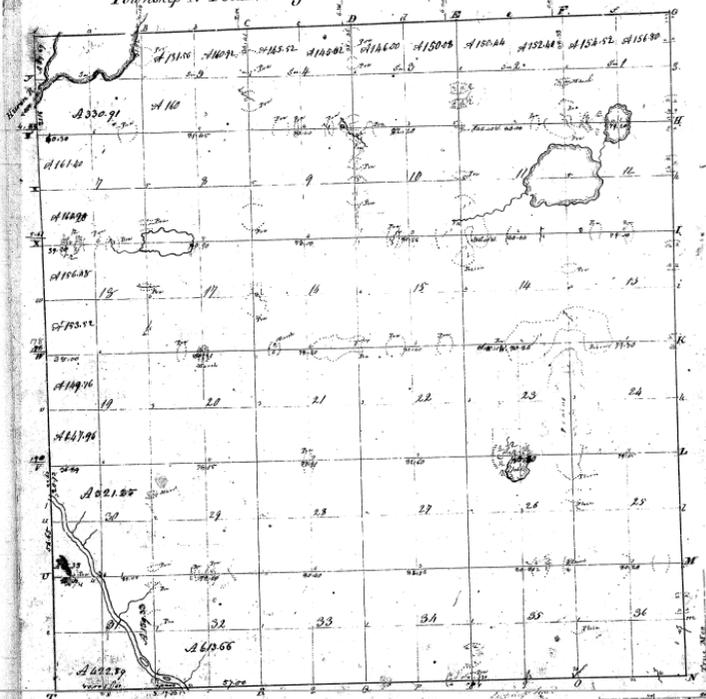

31-6

31-6

Conform to a contract with our instructions from Edward Office Survey General of the United States bearing date the 21st day of April 1854. I have advanced here in and through the above described township, I do hereby certify that it has not been surveyed and found both actual and artificial as are represented on this plat and described in the files with more than 1/2 of an acre with the flat into the Survey General's Office.

Witness this 15th day of September 1854

*[Signature]*  
 J. W. ...  
 Surveyor General