



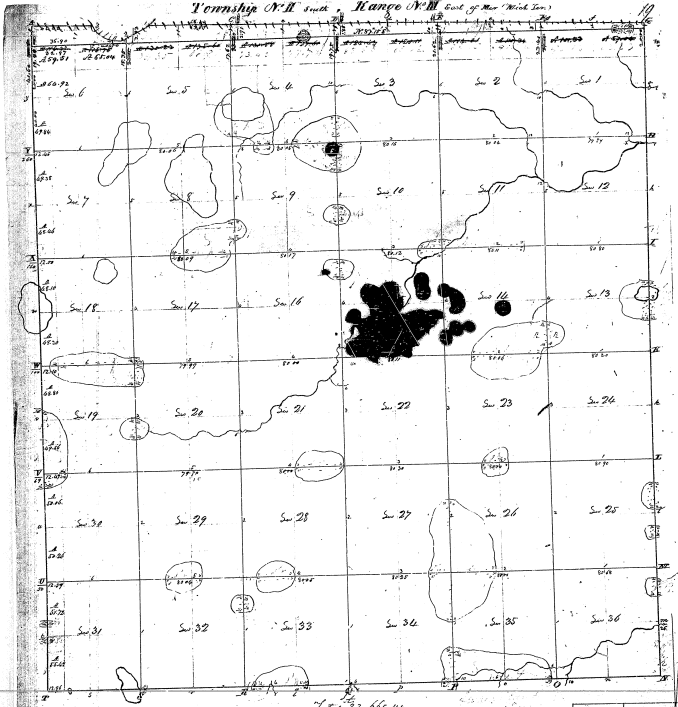

Total 32 866.44

Passant to a book with an instruction from Edward J. Sawyer General of the United States, bearing date the 29th day of June 1820, and containing the above described land, and do hereby certify that the said land was surveyed and located both natural and artificial as are reported in said plat and described in the first one or more thereof, and returned with this plat into the Surveyor General's Office, bearing the date of 1820

John M. Wood

Feb. 1821

300

20-7