Township No. II south, Range No. VI East of Mer. (Mer. Ter.) 45

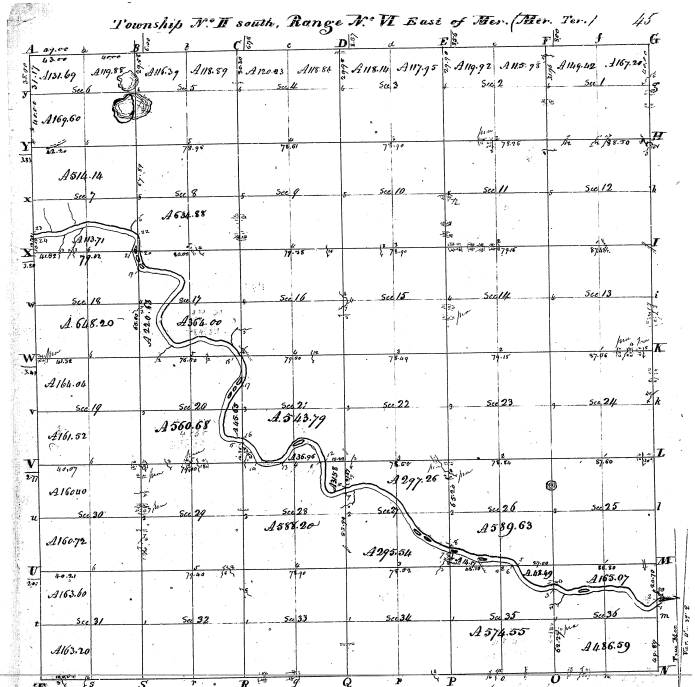

Pursuant to a contract with and instructions from Edward S. Ofie Surveyor General of the United States, bearing date the day of April 1819 - I have ordonnancied lady out and surveyed the above described Township & I do hereby certify that it had such marks and bounds both natural and artificial as are represented on said plat and described in the field notes made thereof & returned with the plat into the Surveyor Generals Office -

Certified the 15th day of September 1819 -

J. Wampler Del.