31-9

31-9

Township No. II South, Range No. VII East of Mer. (Mich. Ter.) 56

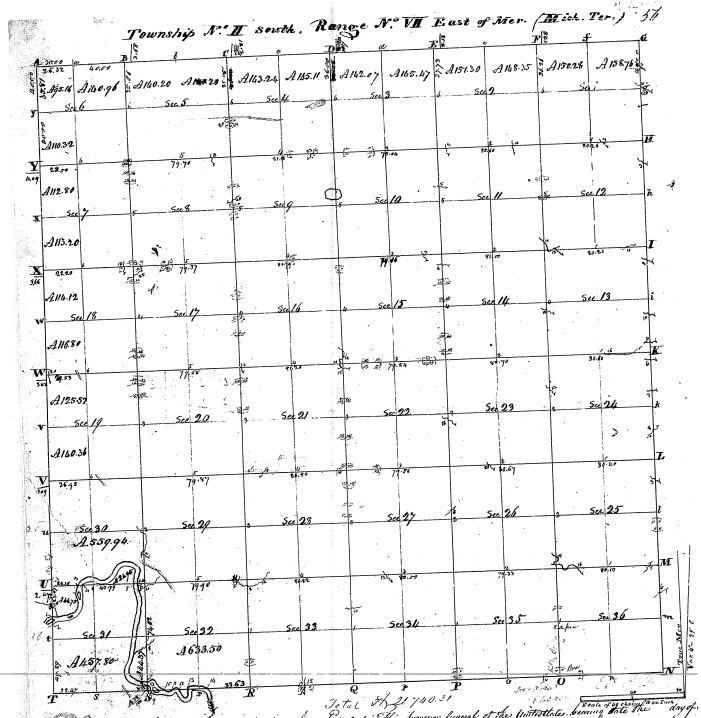

Total Ft 21740.31

Pursuant to a Contract with and instructions from Edward Tiffin Surveyor General of the United States bearing date the day of April 1819. I have admeasured laid out and surveyed the above described Township. & I do hereby certify that it has single marks and bounds both natural and artificial as are represented on said plat and described in the field Notes made thereof & returned with the plat into the Surveyor General's Office —

Certified this 15 day of September 1819 —

H. Wampler Del.