


Township N^o III South, Range N^o VI East of Mer. (North 50^o)

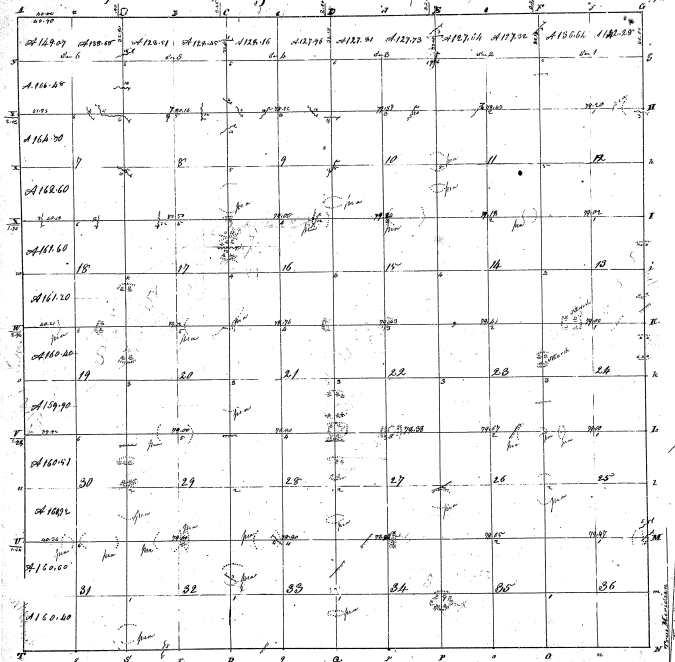

31-14

31-15

office

Witnessed this 18th day of September 1849

Wm. Miller T. C.