30-16

30-16

Township No. IV Range No. IV East of Mer. (Mich. Ter.)

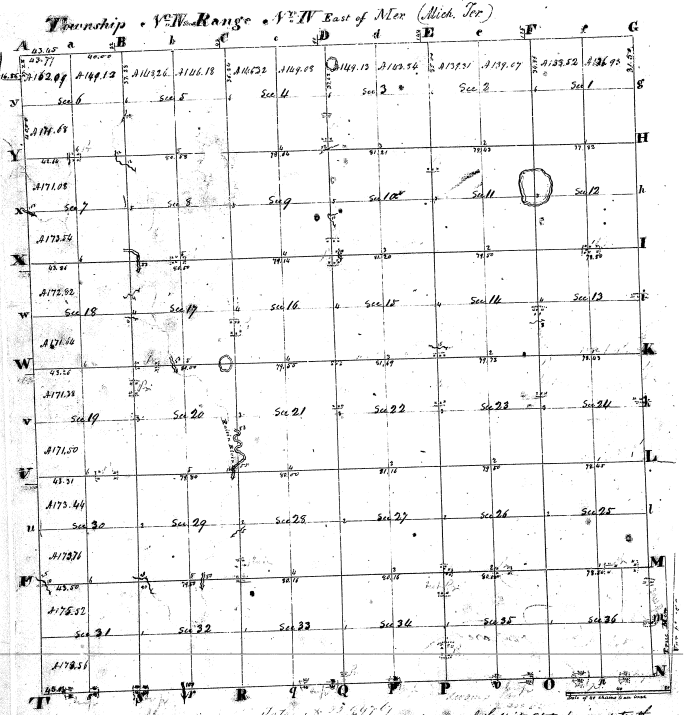

Pursuant to a contract with and instructions from Edward Tiffin Surveyor General of the United States bearing date the I have admeasured, laid out and surveyed the above described Township and do hereby certify that it has such marks and bounds both natural and artificial as are represented on said plat and described in the field notes thereof and returned with the plat into the Surveyor General's Office —

Certified this 4th Novr 1819

Joseph Francis L.S.