



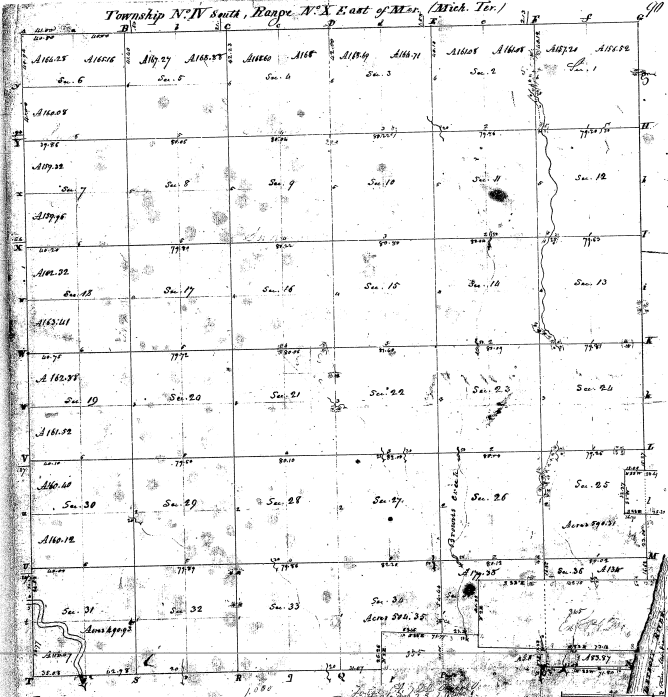



32-37
32-37