Re-survey

Township N.o 21 N. Range N.o 9 W. Mer. Mich.

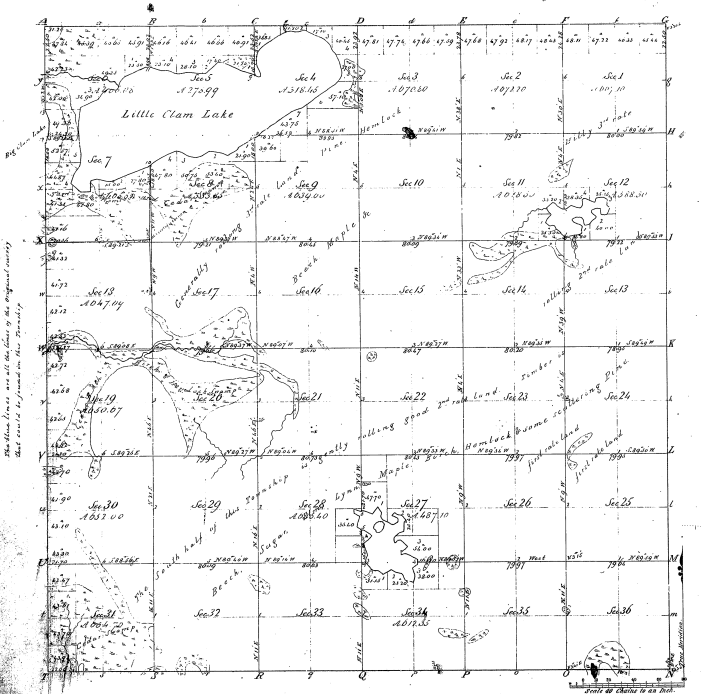

The thick lines are all the lines of the Original survey that could be found on this Township

Total number of Acres 21776.35

Surveys, Designated.	By Whom Surveyed.	Date of Contract.	Amount of Surveys At Cts. Dls.	When Surveyed.	When Charged to the Surveyor-Gen.l and Cr.
Township Lines.	John Harris	Jn.e 4.th 1836	10 . 01 . 30	3.d qr. 1838	
The Survey of the Meanders of Clam Lake	Thos. Ely	Dec.r 26.th 1846	65 . 73 . 32	1.st qr. 1848	

The above Plats of Township N.o 21 North of Range N.o 9 West of the Principal Meridian, Mich.gan, is strictly conformable to the field notes of the survey thereof on file in this Office, which have been examined and approved.

Surveyor General's Office
Detroit June 6.th 1849

Lucius Lyon, Surv.r Gen.l

Meanders of								
Lake	Contains	Ch.	Lks.	Lake	Contains	Ch.	Lks.	Lake	Contains	Ch.	Lks.
Tot. l.			12.00.00								

16-37