


Re-Survey
Township 1° 23' N **Range N° 10 W** **Mer.**

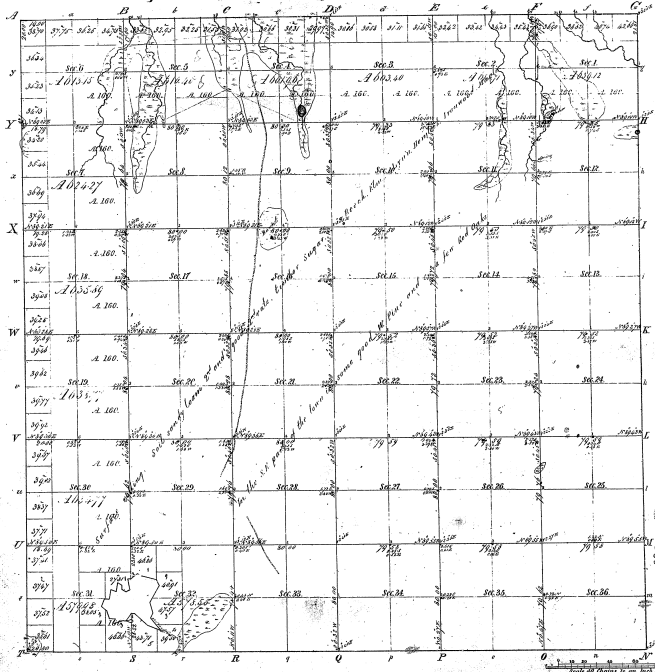

Meanders of




Total number of Acres 22,735.97				

The above copy of Township 1° 23' North of the Principal Meridian and Range N° 10 West is a truly correct and true field notes of the survey being made for the school here, has been examined and approved.
 Surveyor General's Office
 St. Louis, Mo. 4th 1854
Seander, Surveyor General