

MAR 04 1998

LAND CORNER RECORDATION CERTIFICATE

SECTION

FILING REQUIREMENT OF ACT 74, MICH. P.A. 1970

1997 Alcona County Remonumentation

RECORDED LAND CORNER  
P.A. 845 of 1990  
ALCONA COUNTY

FOR CORNERS OF--	LOCATED IN--	CORNER CODE NUMBER
1. PUBLIC LAND SURVEY	T. 25N N. S., R. 5E E. W.	SW cor. S. 31 A-13
2. PROPERTY CONTROLLING IN SECTION	T. N. S., R. E. W.	
3. MISCELLANEOUS PROPERTY IN SECTION	T. N. S., R. E. W.	
4. LOT NO. _____, RECORDED PLAT _____		
5. PRIVATE CLAIMS _____		

Date 7/24/97  
 County/Rep. Dal B Co  
 RECORDED  
 Date September 8, 1997  
 REMON LIBER 1 PAGE 249  
 Time 2:15 PM  
*Sarah Spitzer*  
 Doris A. Gauthier  
 REGISTER OF DEEDS,  
 REGISTER OF DEEDS STAMP AND FILING NUMBER

I, John F. Oliver do hereby certify that under requirements of P.A. 74, Michigan P.A. of 1970, the corner points mentioned in lines 1 and 2 above (identified with circles on index code diagram - over) were, in a field survey on Aug. 20, 1997, established, re-established, monumented, re-monumented, recovered or restored as expressed below and in conformance with regulations and rules therefore as required in the current manual of survey instructions of the United States Department of the Interior, Bureau of Land Management or by a decree of a court of law. Furthermore, that the corner points mentioned in lines 3, 4 and 5 above were, in a field survey on \_\_\_\_\_ 19\_\_\_\_, found, recovered, restored, established or re-established as expressed below and in conformance with the rules of the Michigan State Board of Registration for Land Surveyors or, by a Decree of a Court of law:

A. Description of original monument and accessories and/or subsequent restoration:

- 1838: G.L.O. - set post and referenced
- 1906: E. Chapelle - gray boulder 12 x 12 w + on top
- 1929: Dependent resurvey - fd. 3/4" pipe with wood post - placed 6" x 24" conc. mon. w brass tablet
- 1961: Scott Eng. - fd. nothing - placed nail and cap
- 1984: R. Griffin - fd. 5" x 36" sq. conc. mon. w brass cap

B. Description of corner evidence found and/or method applied in restoring or re-establishing corner:

fd. Dependent resurvey conc. mon. one foot below surface of asphalt road

C. Description of monument for corner and accessories established to perpetuate locating the position of the corner:

Placed pavement box over conc. mon.

referenced: conc. r/w marker / N 26°E / 93.30 ft  
 post / East / 33.30 ft  
 power pole / S 60°W / 84.30 ft  
 SE cor. house / N 43°W / 114.90 ft

the above four accessories are given by R. Griffin in Liber 1 C.R.C. pg. 135


SIGNED BY \_\_\_\_\_ DATE \_\_\_\_\_

SURVEYOR'S MICHIGAN REGISTRATION NO. 19840

FOR STATE AND UNITED STATES AGENCIES:

SIGNED BY \_\_\_\_\_ CHIEF OF SURVEY PARTY DATE \_\_\_\_\_

APPROVED AND SIGNED BY \_\_\_\_\_ MICHIGAN REGISTERED LAND SURVEYOR DATE \_\_\_\_\_

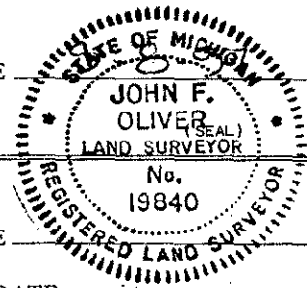

SURVEYOR'S MICHIGAN REGISTRATION NO. \_\_\_\_\_