

MAR 03 2000

LAND CORNER RECORDATION CERTIFICATE

SECTION FILING REQUIREMENT OF ACT 74, MICH. P.A.1970

1999 Alcona County Remonumentation

| FOR CORNERS OF-- | LOCATED IN-- | CORNER CODE NUMBER |
|--|--------------------------------|--------------------|
| 1. PUBLIC LAND SURVEY _____ | T. 25N N. S., R. 5E E. W. | C-4 |
| 2. PROPERTY CONTROLLING IN SECTION _____ | T. _____ N. S., R. _____ E. W. | |
| 3. MISCELLANEOUS PROPERTY IN SECTION _____ | T. _____ N. S., R. _____ E. W. | |
| 4. LOT NO. _____, RECORDED PLAT _____ | | |
| 5. PRIVATE CLAIMS _____ | | |

Alcona County
Remonumentation
Book 2 Page 23

Filed for Record in
ALCONA COUNTY MICHIGAN
DORIS A GAUTHIER
On 12-17-1999 At 10:32 am
LAND CORNER 9.00

REGISTER OF DEEDS STAMP AND
FILING NUMBER

I, John F. Oliver do hereby certify that under requirements of P.A. 74, Michigan P.A. of 1970, the corner points mentioned in lines 1 and 2 above (identified with circles on index code diagram - over) were, in a field survey on Dec. 8, 1999, established, re-established, monumented, re-monumented, recovered or restored as expressed below and in conformance with regulations and rules therefore as required in the current manual of survey instructions of the United States Department of the Interior, Bureau of Land Management or by a decree of a court of law. Furthermore, that the corner points mentioned in lines 3, 4 and 5 above were, in a field survey on _____ 19____, found, recovered, restored, established or re-established as expressed below and in conformance with the rules of the Michigan State Board of Registration for Land Surveyors or, by a Decree of a Court of law:

A. Description of original monument and accessories and/or subsequent restoration:

C-4: 1845: GLO survey by J. Mullett - set post and referenced
 1900: sur. by A. Freer - set cedar stake
 1931: dependent resur. by G. Veal - set 6" x 24" conc. mon. w brass tablet
 1990: sur. by N. Caldwell - rd. 1/2" re-rod over USGLO mon. (sur. for USFS)

B. Description of corner evidence found and/or method applied in restoring or re-establishing corner:

C-4: fd. 1/2" rod (no cap) over GLO conc. mon. w brass cap and four witnesses from 1990 Caldwell survey.
 no evidence recovered from GLO survey of 1845
 distances and alignment are compatible with survey of 1931
 accepted as the correct location for the corner

C. Description of monument for corner and accessories established to perpetuate locating the position of the corner:

C-4: placed 1/2" rod and aluminum cap referenced:
 6" ash / N 40°E / 65.25' to exist. nail all four are previous
 7" tw. ash / N 82°W / 76.93' to exist. nail witnesses from USFS
 7" elm / N 83°E / 41.10' to exist. nail sur. by N. Caldwell
 5/8" rod and cap #12018 / East / 33.00'

APPROVED LAND CORNER
P A 345 of 1990
ALCONA COUNTY


Date 11/30/99
County Rep. John F. Oliver DATE Dec. 8, 1999

SIGNED BY John F. Oliver
SURVEYOR'S MICHIGAN REGISTRATION NO. 19840

FOR STATE AND UNITED STATES AGENCIES:

SIGNED BY _____ DATE _____
CHIEF OF SURVEY PARTY

APPROVED AND SIGNED BY _____ DATE _____
MICHIGAN REGISTERED LAND SURVEYOR

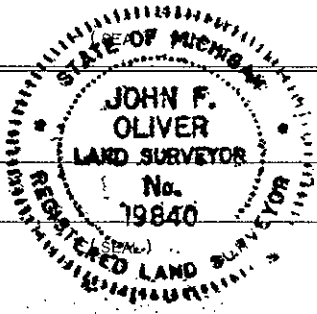

SURVEYOR'S MICHIGAN REGISTRATION NO. _____