

SURVEY & REMONUMENTATION

MAR 04 1998

LAND CORNER RECORDATION CERTIFICATE

SECTION FILING REQUIREMENT OF ACT 74, MICH. P.A.1970

1997 Alcona County Remonumentation

APPROVED LAND CORNER
P A 345 of 1890
ALCONA COUNTY

FOR CORNERS OF--:	LOCATED IN--:	CORNER CODE NUMBER
1. PUBLIC LAND SURVEY _____	T. 25N N. S., R. 5E E. W.	S-174 cor. 17 D-7
2. PROPERTY CONTROLLING IN SECTION _____	, T. _____ N. S., R. _____ E. W.	_____
3. MISCELLANEOUS PROPERTY IN SECTION _____	, T. _____ N. S., R. _____ E. W.	_____
4. LOT NO. _____	, RECORDED PLAT _____	_____
5. PRIVATE CLAIMS _____	_____	_____

Date 7/24/97
County Rep. DPA

RECORDED
Date September 8, 1997
REMON LIBER 1 PAGE 258
2:20 Time P M
Doris A. Gauthier
Doris A. Gauthier
REGISTER OF DEEDS
REGISTER OF DEEDS STAMP AND FILING NUMBER

I, John F. Oliver do hereby certify that under requirements of P.A. 74, Michigan P.A. of 1970, the corner points mentioned in lines 1 and 2 above (identified with circles on index code diagram - over) were, in a field survey on Aug. 20, 1997, established, re-established, monumented, re-monumented, recovered or restored as expressed below and in conformance with regulations and rules therefore as required in the current manual of survey instructions of the United States Department of the Interior, Bureau of Land Management or by a decree of a court of law. Furthermore, that the corner points mentioned in lines 3, 4 and 5 above were, in a field survey on _____ 19____, found, recovered, restored, established or re-established as expressed below and in conformance with the rules of the Michigan State Board of Registration for Land Surveyors or, by a Decree of a Court of law:

A. Description of original monument and accessories and/or subsequent restoration:

- 1845: G.L.O. - set post and referenced
- 1933: Dependent resurvey - placed 6" x 24" conc. mon. w brass tablet
- 1973: R. Miller - no desc. of corner
- 1977: R. Miller - C.R.C. - placed 1/2" re-rod and cap
- 1979: B. Woods - fd. 1/2" rod and cap (C.R.C.)


B. Description of corner evidence found and/or method applied in restoring or re-establishing corner:

fd. 1/2" bar and cap with three accessories listed B. Woods recordation, Liber 1 C.R.C., P. 87.

C. Description of monument for corner and accessories established to perpetuate locating the position of the corner:

- placed 1/2" rod with aluminum cap stamped to identify the corner
- references: 6" twin cherry / S 25°E / 43.20 ft
double apple / S 48°E / 54.30 ft
power pole / N 10°E / 63.40 ft
fence corner of fence E, W and N / N 5°E / 32.09 ft

SIGNED BY *[Signature]* DATE _____
SURVEYOR'S MICHIGAN REGISTRATION NO. 19840

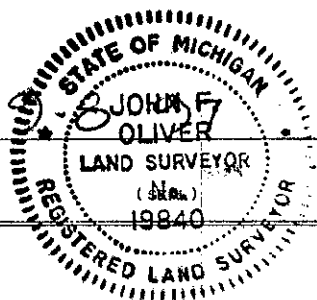

FOR STATE AND UNITED STATES AGENCIES:
SIGNED BY _____ DATE _____
CHIEF OF SURVEY PARTY
APPROVED AND SIGNED BY _____ DATE _____
MICHIGAN REGISTERED LAND SURVEYOR (SEAL)