

MAR 04 1998

SECTION LAND CORNER RECORDATION CERTIFICATE

FILING REQUIREMENT OF ACT 74, MICH. P.A. 1970

1997 Alcona County Remonumentation

APPROVED LAND CORNER P A 345 of 1990 ALCONA COUNTY

Table with columns: FOR CORNERS OF--, LOCATED IN--, CORNER CODE NUMBER. Includes rows for PUBLIC LAND SURVEY, PROPERTY CONTROLLING IN SECTION, MISCELLANEOUS PROPERTY IN SECTION, LOT NO., and PRIVATE CLAIMS.

Date 7/24/97 County Rep. [Signature] RECORDED Date September 8, 1997 REMON LIBER 1 PAGE 259 2:25 Time P M Doris A. Gauthier REGISTER OF DEEDS REGISTER OF DEEDS STAMP AND FILING NUMBER

I, John F. Oliver do hereby certify that under requirements of P.A. 74, Michigan P.A. of 1970, the corner points mentioned in lines 1 and 2 above (identified with circles on index code diagram - over) were, in a field survey on Aug. 20, 1997, established, re-established, monumented, re-monumented, recovered or restored as expressed below and in conformance with regulations and rules therefore as required in the current manual of survey instructions of the United States Department of the Interior, Bureau of Land Management or by a decree of a court of law.

A. Description of original monument and accessories and/or subsequent restoration:

- 1845: G.L.O. - set post and referenced
1914: A. Freer - sleigh shoe 34" long - 3" wide
1933: Dependent resurvey - placed 6" x 24" conc. mon. w brass cap
1979: B. Woods - fd. GLO mon. w brass cap


B. Description of corner evidence found and/or method applied in restoring or re-establishing corner:

fd. railroad spike with Dependent resurvey mon. below with three accessories listed in Liber 1 C.R.C., P. 87 and Dependent resurvey P. 57.

C. Description of monument for corner and accessories established to perpetuate locating the position of the corner:

Placed pavement box over Dependent resurvey monument

- referenced: 24" w. oak / N 13°E / 110.00 ft
18" oak / N 83°W / 40.01 ft
15" w. oak / S21°W / 73.90 ft
15" w. oak / S 65°W / 50.04'

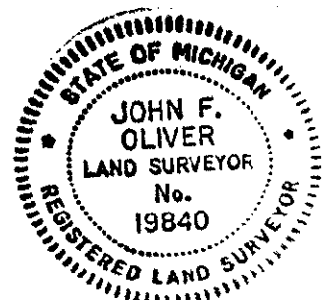

SIGNED BY [Signature] DATE 9-8-97

SURVEYOR'S MICHIGAN REGISTRATION NO. 19840 (SEAL)

FOR STATE AND UNITED STATES AGENCIES:

SIGNED BY CHIEF OF SURVEY PARTY DATE

APPROVED AND SIGNED BY MICHIGAN REGISTERED LAND SURVEYOR DATE (SEAL)

SURVEYOR'S MICHIGAN REGISTRATION NO.