

MAR 03 2000 AND CORNER RECORDATION CERTIFICATE

FILING REQUIREMENT OF ACT 74, MICH. P.A.1970

SECTION

1999 Alcona County Remonumentation

FOR CORNERS OF--	LOCATED IN--	CORNER CODE NUMBER
1. PUBLIC LAND SURVEY	T. 25N N. S., R. 5E E. W.	E-9
2. PROPERTY CONTROLLING IN SECTION	, T. _____ N. S., R. _____ E. W.	
3. MISCELLANEOUS PROPERTY IN SECTION	, T. _____ N. S., R. _____ E. W.	
4. LOT NO. _____, RECORDED PLAT _____		
5. PRIVATE CLAIMS _____		

Alcona County Remonumentation
 Liber 2 Page 25
 Filed for Record in
 ALCONA COUNTY MICHIGAN
 DORIS A GAUTHIER
 On 12-17-1999 At 10:32
 LAND CORNER 9.00
 REGISTER OF DEEDS STAMP AND FILING NUMBER

I, John F. Oliver do hereby certify that under requirements of P.A. 74, Michigan P.A. of 1970, the corner points mentioned in lines 1 and 2 above (identified with circles on index code diagram—over) were, in a field survey on Dec. 8, 1999, established, re-established, monumented, re-monumented, recovered or restored as expressed below and in conformance with regulations and rules therefore as required in the current manual of survey instructions of the United States Department of the Interior, Bureau of Land Management or by a decree of a court of law. Furthermore, that the corner points mentioned in lines 3, 4 and 5 above were, in a field survey on _____ 19____, found, recovered, restored, established or re-established as expressed below and in conformance with the rules of the Michigan State Board of Registration for Land Surveyors or, by a Decree of a Court of law:

A. Description of original monument and accessories and/or subsequent restoration:

- E-9: 1845: GLO sur. by J. Mullett - set post and referenced
- 1915: sur. by A. Freer - cor. is casting 40" long-4" wide-1" thick with broken glass under
- 1931: dep. resur. by G. Veal - set brass tablet on 6"x24" conc. mon.
- 1973: sur. by R. Miller - fd. GLO mon.
- 1995: sur. by D. MacNeill - fd. conc. mon. with brass cap
- 1998: sur. by NE Land Surveys - no description of corner

B. Description of corner evidence found and/or method applied in restoring or re-establishing corner:

- E-9: found 6" x 24" conc. mon. with brass tablet with four witnesses from dependent resurvey of 1931 (two are stumps) and two witnesses from 1973 survey.
- no evidence recovered from GLO survey of 1845
- distances and alignment are compatible with surveys of 1931, 1973, 1995 and 1998.
- accepted as the correct location for the corner

C. Description of monument for corner and accessories established to perpetuate locating the position of the corner:


- E-9: 6" x 24" conc. mon. with brass tablet referenced:
 - (from 1973 sur.) 6" dbl. maple / S 32°E / 111.00' to exist. nail
 - (from 1973 sur.) 9" w. oak / N 45°E / 71.02' to exist nail
 - APPROVED LAND CORNER 8" w. oak / S 60°W / 92.80 ft to nail
 - P A 345 of 1990 5" w. oak / N 65°W / 63.45' to nail
 - ALCONA COUNTY

Date 11/30/99
 County Rep. [Signature]

SIGNED BY John F. Oliver DATE Dec. 8, 1999
 SURVEYOR'S MICHIGAN REGISTRATION NO. 19840

FOR STATE AND UNITED STATES AGENCIES:

SIGNED BY _____ CHIEF OF SURVEY PARTY DATE _____
 APPROVED AND SIGNED BY _____ MICHIGAN REGISTERED LAND SURVEYOR DATE _____

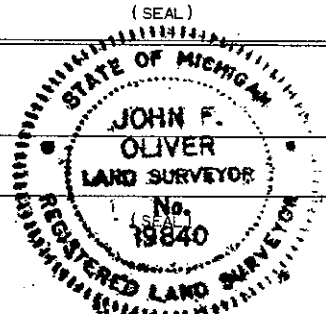

SURVEYOR'S MICHIGAN REGISTRATION NO. _____