

SURVEY & REMONUMENTATION

APR 25 1995

COMMISSION

1994 ALCONA COUNTY REMONUMENTATION CORNER

LAND CORNER RECORDATION CERTIFICATE
Filing Requirement of Act 74, Mich. P.A. 1970

APPROVED LAND CORNER
P A 345 of 1990
ALCONA COUNTY
Date RECORDED 3-16-95
County Rep. E. J. J.
Liber 1 Page 109
MAR 10 11 21 AM '95

For corners in <u>Alcona</u> (County)	Located In:	Corner Code #
1. Public Land Survey	T 25N R 6E	A-6
	T _____ R _____	_____
	T _____ R _____	_____
	T _____ R _____	_____
2. Property Controlling in Section	S _____ T _____ R _____	_____
	S _____ T _____ R _____	_____
3. Miscellaneous Property in Sec.	S _____ T _____ R _____	_____
	S _____ T _____ R _____	_____

Doris A. Gaultier
REGISTERED OF DEEDS
ALCONA COUNTY MICHIGAN

Register of Deeds Stamp & File Number

4. Lot No. _____, Recorded Plat _____
5. Private Claims _____

	A	B	C	D	E	F	G	H	I	J	K	L	M
2	6		5		4		3		2		1		
3													
4	7		8		9		10		11		12		
5													
6	18		17		16		15		14		13		
7													
8	19		20		21		22		23		24		
9													
10	30		29		28		27		26		25		
11													
12	31		32		33		34		35		36		
13													

I, Duane R. MacNeill, in a field survey on August 30, 19 94, do hereby certify that under requirements of P.A. 74, Michigan P.A. of 1970, the corner points mentioned in lines 1 and 2 above were in conformance with regulations and rules therefore as required in the current manual of survey instructions of the United States Department of the Interior, Bureau of Land Management or by a decree of a Court of Law and/or that the corner points mentioned in lines 3, 4 and 5 above were in conformance with the rules of the Michigan Board of Land Surveyors or by a Decree of a Court of Law; established, re-established, monumented, re-monumented, recovered, found as expressed below:


NOTE: Not more than 4 corners, all in the same town and range, may be recorded on this certificate.

A. Description of original monument and accessories and/or subsequent restoration:
1844 - Cedar Post set by Government Surveyor
1901 - Surveyor, W.L. Chapelle finds 11" x 16" stone with chiseled "X"
1968 - Surveyor, N. Caldwell placed 1/2" re-rod & R.L.S. cap.
Witnesses:
S56°W 32.2 20" Maple
N72°E 119.3 Power Pole
S48°E 45.0 Power Pole
No Witnesses

B. Description of corner evidence found and/or method applied in restoring or reestablishing corner:
Caldwell's corner was found to be proportionally acceptable between G.L.O. concrete monument found at A-5 and another found at A-7, thus corner was certified at this location.

C. Description of monument for corner and accessories established to perpetuate locating the position of the corner:
1994 - Remonumentation Crew found 1/2" re-rod with cap. An Alcona County brass remonumentation cap, appropriately stamped, was secured to the re-rod and 8" below surface of ground.
Witnesses:
S60°W 31.70 20" Maple
N15°W 68.10 20" Maple
S60°E 45.26 Power Pole
N70°E 119.98 Power Pole

Signed by Duane R. MacNeill
Surveyor's Michigan License No. 19237

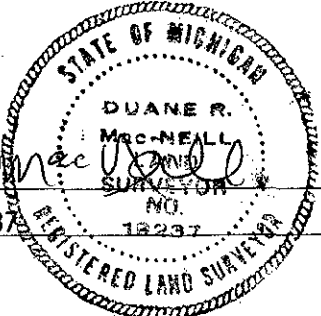

Date December 28, 1994