

# SURVEY & REMONUMENTATION

APR 25 1995

COMMISSION

## 1994 ALCONA COUNTY REMONUMENTATION CORNER LAND CORNER RECORDATION CERTIFICATE Filing Requirement of Act 74, Mich. P.A. 1970

APPROVED LAND CORNER  
P A 345 of 1990  
ALCONA COUNTY  
Date: 3-10-95  
County Rep. E. J. [Signature]  
RECORDED

For corners in

Alcona  
(County)

Located In:

Corner Code # Alcona County  
Remonumentation  
Liber 1 Page 112

- |                                    |   |            |   |           |     |
|------------------------------------|---|------------|---|-----------|-----|
| 1. Public Land Survey              | T | <u>25N</u> | R | <u>6E</u> | B-7 |
|                                    | T |            | R |           |     |
|                                    | T |            | R |           |     |
|                                    | T |            | R |           |     |
| 2. Property Controlling in Section | S |            | T | R         |     |
|                                    | S |            | T | R         |     |
| 3. Miscellaneous Property in Sec.  | S |            | T | R         |     |
|                                    | S |            | T | R         |     |

MAR 10 11 22 AM '95

*Doris A. Buntcher*  
REGISTER OF DEEDS  
ALCONA COUNTY, MICHIGAN

Register of Deeds Stamp & File Number

4. Lot No. \_\_\_\_\_, Recorded Plat \_\_\_\_\_  
5. Private Claims \_\_\_\_\_

	A	B	C	D	E	F	G	H	I	J	K	L	M
2	6		5		4		3		2		1		
3													
4	7		8		9		10		11		12		
5													
6	18		17		16		15		14		13		
7	●												
8	19		20		21		22		23		24		
9													
10	30		29		28		27		26		25		
11													
12	31		32		33		34		35		36		
13													

I, Duane R. MacNeill, in a field survey on August 30, 1994, do hereby certify that under requirements of P.A. 74, Michigan P.A. of 1970, the corner points mentioned in lines 1 and 2 above were in conformance with regulations and rules therefore as required in the current manual of survey instructions of the United States Department of the Interior, Bureau of Land Management or by a decree of a Court of Law and/or that the corner points mentioned in lines 3, 4 and 5 above were in conformance with the rules of the Michigan Board of Land Surveyors or by a Decree of a Court of Law; established, re-established, monumented, re-monumented, recovered, found as expressed below:

**NOTE: Not more than 4 corners, all in the same town and range, may be recorded on this certificate.**

A. Description of original monument and accessories and/or subsequent restoration:

1844 - Cedar post set by Government Surveyor

1968 - Surveyor, N. Caldwell sets 1/2" re-rod and cap proportionally on line between A-7 and C-7.

Witnesses:

Beech 8 S64°E 54  
Beech 4 S33°W 07

Witnesses:

S45°E 50.2 Power Pole  
S40°E 66.2 Apple Tree  
N36°W 46.4 24" Maple  
S18°W 46.4 Birch Stump

B. Description of corner evidence found and/or method applied in restoring or reestablishing corner:

Caldwell's corner was established between U.S.G.L.O. concrete monument (A-7) and established Section corner (C-7), which was tied into during Platting of Maple Ridge Subdivision; thus this corner was accepted in its location.


C. Description of monument for corner and accessories established to perpetuate locating the position of the corner:

1994 - Remonumentation Crew found capped 1/2" re-rod. An Alcona County brass cap, appropriately stamped, was secured to the existing 1/2" re-rod and witnessed.

Witnesses:

N45°E 46.96 Concrete Monument  
S45°E 44.52 Power Pole  
S10°E 95.55 10" Apple  
S80°W 123.98 Power Pole

Signed by *Duane R. MacNeill*  
Surveyor's Michigan License No. 19237

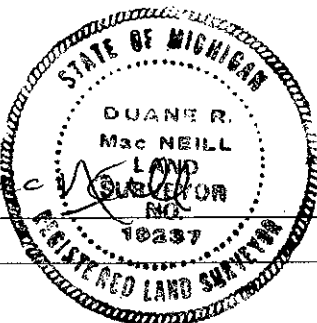

Date December 28, 1994