

# SURVEY & REMONUMENTATION

## 1994 ALCONA COUNTY REMONUMENTATION CORNER

APR 25 1995

### LAND CORNER RECORDATION CERTIFICATE Filing Requirement of Act 74, Mich. P.A. 1970

APPROVED LAND CORNER  
P A 345 of 1990  
RE ALCONA COUNTY

For corners in  
Alcona  
(County)

Date ETL  
County Rep. Mar 10 10 22 AM '95

- |                                       |                          |                          |
|---------------------------------------|--------------------------|--------------------------|
| 1. Public Land Survey                 | T <u>25N</u> R <u>6E</u> | Corner Code # <u>C-6</u> |
|                                       | T _____ R _____          | _____                    |
|                                       | T _____ R _____          | _____                    |
|                                       | T _____ R _____          | _____                    |
| 2. Property Controlling in Section    | S _____ T _____ R _____  | _____                    |
|                                       | S _____ T _____ R _____  | _____                    |
| 3. Miscellaneous Property in Sec.     | S _____ T _____ R _____  | _____                    |
|                                       | S _____ T _____ R _____  | _____                    |
| 4. Lot No. _____, Recorded Plat _____ |                          |                          |
| 5. Private Claims _____               |                          |                          |

Alcona County  
Remonumentation  
Liber Page 113  
REGISTERED LAND SURVEYOR  
ALCONA COUNTY MICHIGAN

Register of Deeds Stamp & File Number

	A	B	C	D	E	F	G	H	I	J	K	L	M
2	6		5		4		3		2		1		
3													
4	7		8		9		10		11		12		
5													
6	18		17		16		15		14		13		
7													
8	19		20		21		22		23		24		
9													
10	30		29		28		27		26		25		
11													
12	31		32		33		34		35		36		
13													

I, Duane R. MacNeill, in a field survey on August 30, 19 94, do hereby certify that under requirements of P.A. 74, Michigan P.A. of 1970, the corner points mentioned in lines 1 and 2 above were in conformance with regulations and rules therefore as required in the current manual of survey instructions of the United States Department of the Interior, Bureau of Land Management or by a decree of a Court of Law and/or that the corner points mentioned in lines 3, 4 and 5 above were in conformance with the rules of the Michigan Board of Land Surveyors or by a Decree of a Court of Law; established, re-established, monumented, re-monumented, recovered, found as expressed below:

**NOTE: Not more than 4 corners, all in the same town and range, may be recorded on this certificate.**

A. Description of original monument and accessories and/or subsequent restoration:

1844 - Post in pond by Government Surveyor

1968 - Surveyor N. Caldwell re-establishes corner in pond by old fence post but did not set iron.

W. Birch 10 N72°E 1.28  
N.B.T. W. Pine Stump 24 N54°E 70  
N41°W 93

No Witnesses Supplied

1986 - Survey J. Oliver, finds 1" pipe away from pond.

B. Description of corner evidence found and/or method applied in restoring or reestablishing corner:

Set 1/4 corner on straight line between C-5 and C-7 and on extension of old fence line to West. Point fell in pond and was S62°E 54.11 feet from previously found 1" pipe.


C. Description of monument for corner and accessories established to perpetuate locating the position of the corner:

1994 - Remonumentation Crew set 6' long 3/4" pipe with 1/2" re-rod wedged into 3/4" pipe, an Alcona County Brass Cap, appropriately stamped, was secured to 1/2" re-rod and witnessed.

Witnesses:

N45°W 51.27 10" Triple Oak  
N30°W 31.53 6" Ironwood  
S65°W 28.58 12" Birch  
S85°W 42.09 5" Spruce

Signed by Duane R. MacNeill  
Surveyor's Michigan License No. 19237

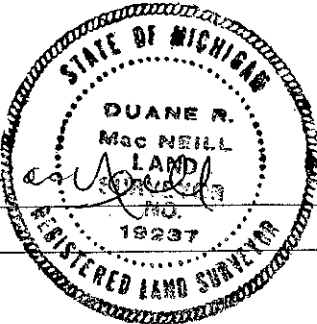

Date December 28, 1994