

SURVEY & REMONUMENTATION

APR 25 1995

COMMISSION

For corners in

Alcona
(County)

Located In:

Corner Code -#

- | | | | | | |
|------------------------------------|---|------------|---|-----------|------------|
| 1. Public Land Survey | T | <u>25N</u> | R | <u>6E</u> | <u>D-5</u> |
| | T | _____ | R | _____ | _____ |
| | T | _____ | R | _____ | _____ |
| | T | _____ | R | _____ | _____ |
| 2. Property Controlling in Section | S | _____ | T | _____ | _____ |
| | S | _____ | T | _____ | _____ |
| 3. Miscellaneous Property in Sec. | S | _____ | T | _____ | _____ |
| | S | _____ | T | _____ | _____ |
4. Lot No. _____, Recorded Plat _____
5. Private Claims _____

I, Duane R. MacNeill, in a field survey on August 30, 19 94, do hereby certify that under requirements of P.A. 74, Michigan P.A. of 1970, the corner points mentioned in lines 1 and 2 above were in conformance with regulations and rules therefore as required in the current manual of survey instructions of the United States Department of the Interior, Bureau of Land Management or by a decree of a Court of Law and/or that the corner points mentioned in lines 3, 4 and 5 above were in conformance with the rules of the Michigan Board of Land Surveyors or by a Decree of a Court of Law; established, re-established, monumented, re-monumented, recovered, found as expressed below:

NOTE: Not more than 4 corners, all in the same town and range, may be recorded on this certificate.

A. Description of original monument and accessories and/or subsequent restoration:

1844 - Cedar post set by Government Surveyor 1990's - No known surveys in area.

Witnesses:

W. Pine 10 N01°W 65

B. Description of corner evidence found and/or method applied in restoring or reestablishing corner:

Established 1/4 corner by projecting fence lines from North back to Centerline of Easterly-Westerly County Road. This point proportioned out reasonably well between C-5 and E-5 and was about 30 feet North of an old corner fence post to the South.

C. Description of monument for corner and accessories established to perpetuate locating the position of the corner:

1994 - Remonumentation Crew set 1/2" re-rod.
An Alcona County Brass Cap, appropriately stamped, was secured to the 1/2" re-rod and witnessed.

Witnesses:

N25°E 53.78 Power Pole
N25°W 52.09 16" W. Pine
N55°W 73.64 6" W. Pine
Due South 29.54 Fence Post

Alcona County Remonumentation
APPROVED LAND CORNER
Liber PA 345 of 1990

ALCONA COUNTY

Date RECORDED

County Rep Carl T. J.


MAR 10 10 22 AM '95

Doris A. Benthien
REGISTER OF DEEDS
ALCONA COUNTY MICHIGAN

Register of Deeds Stamp & File Number

	A	B	C	D	E	F	G	H	I	J	K	L	M
2	6		5		4		3		2		1		
3													
4	7		8		9		10		11		12		
5													
6	18		17		16		15		14		13		
7													
8	19		20		21		22		23		24		
9													
10	30		29		28		27		26		25		
11													
12	31		32		33		34		35		36		
13													

Signed by Duane R. MacNeill
Surveyor's Michigan License No. 19237

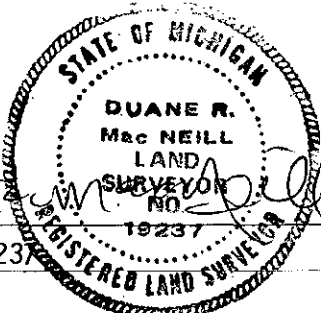

Date December 28, 1994