

# SURVEY & REMONUMENTATION

APR 25 1995

1994 ALCONA COUNTY REMONUMENTATION CORNER

## COMMISSION

### LAND CORNER RECORDATION CERTIFICATE Filing Requirement of Act 74, Mich. P.A. 1970

APPROVED LAND CORNER  
P A 345 of 1990  
ALCONA COUNTY  
RECORDED  
Date 3-10-95  
County Rep. E T J  
Mar 10 10 22 AM '95

For corners in  
Alcona  
(County)

Located In:

Corner Code ##

Alcona County  
Remonumentation  
Page 115

- |                                    |   |            |   |           |            |
|------------------------------------|---|------------|---|-----------|------------|
| 1. Public Land Survey              | T | <u>25N</u> | R | <u>6E</u> | <u>D-6</u> |
|                                    | T |            | R |           |            |
|                                    | T |            | R |           |            |
|                                    | T |            | R |           |            |
| 2. Property Controlling in Section | S |            | T | R         |            |
|                                    | S |            | T | R         |            |
| 3. Miscellaneous Property in Sec.  | S |            | T | R         |            |
|                                    | S |            | T | R         |            |

4. Lot No. \_\_\_\_\_, Recorded Plat \_\_\_\_\_
5. Private Claims \_\_\_\_\_

*James A. Matthews*  
REGISTER OF DEEDS  
ALCONA COUNTY MICHIGAN

Register of Deeds Stamp & File Number

I, Duane R. MacNeill, in a field survey on August 30, 1994, do hereby certify that under requirements of P.A. 74, Michigan P.A. of 1970, the corner points mentioned in lines 1 and 2 above were in conformance with regulations and rules therefore as required in the current manual of survey instructions of the United States Department of the Interior, Bureau of Land Management or by a decree of a Court of Law and/or that the corner points mentioned in lines 3, 4 and 5 above were in conformance with the rules of the Michigan Board of Land Surveyors or by a Decree of a Court of Law; established, re-established, monumented, re-monumented, recovered, found as expressed below:

|    |    |   |    |   |    |   |    |   |    |   |    |   |   |
|----|----|---|----|---|----|---|----|---|----|---|----|---|---|
|    | A  | B | C  | D | E  | F | G  | H | I  | J | K  | L | M |
| 2  | 6  |   | 5  |   | 4  |   | 3  |   | 2  |   | 1  |   |   |
| 3  |    |   |    |   |    |   |    |   |    |   |    |   |   |
| 4  | 7  |   | 8  |   | 9  |   | 10 |   | 11 |   | 12 |   |   |
| 5  |    |   |    |   |    |   |    |   |    |   |    |   |   |
| 6  | 18 |   | 15 |   | 16 |   | 15 |   | 14 |   | 13 |   |   |
| 7  |    |   |    |   |    |   |    |   |    |   |    |   |   |
| 8  | 19 |   | 20 |   | 21 |   | 22 |   | 23 |   | 24 |   |   |
| 9  |    |   |    |   |    |   |    |   |    |   |    |   |   |
| 10 | 30 |   | 29 |   | 28 |   | 27 |   | 26 |   | 25 |   |   |
| 11 |    |   |    |   |    |   |    |   |    |   |    |   |   |
| 12 | 31 |   | 32 |   | 33 |   | 34 |   | 35 |   | 36 |   |   |
| 13 |    |   |    |   |    |   |    |   |    |   |    |   |   |

**NOTE: Not more than 4 corners, all in the same town and range, may be recorded on this certificate.**

**A. Description of original monument and accessories and/or subsequent restoration:**

Not set by original Government Surveyors.

1990's - No known surveys in this area.

**B. Description of corner evidence found and/or method applied in restoring or reestablishing corner:**

Established center of Section on intersection of straight line between D-5 and D-7 and straight line between C-6 and E-6. Corner fell proportionally well with distance from E-6 to N 1/8 corner of SE 1/4. Corner is 13.3 feet South of Centerline of new Bituminous Road and no fences or trees are available.


**C. Description of monument for corner and accessories established to perpetuate locating the position of the corner:**

1994 - Remonumentation Crew set 1/2" re-rod in a monument box. An Alcona County Brass Cap, appropriately stamped, was secured to re-rod.

No Witnesses Available

Monument Box 13.27 feet South of Centerline of newly paved Bituminous Road.

Signed by Duane R. MacNeill  
Surveyor's Michigan License No. 19237

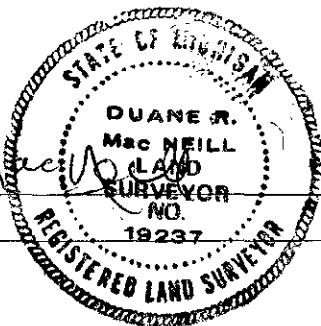

Date December 28, 1994