

SURVEY & REMONUMENTATION

APR 25 1995

1994 ALCONA COUNTY REMONUMENTATION CORNER

LAND CORNER RECORDATION CERTIFICATE Filing Requirement of Act 74, Mich. P.A. 1970

APPROVED LAND CORNER
P A 345 of 1990
ALCONA COUNTY

For corners in
COMMISSION
Alcona
(County)

Located In: Corner Code #

- | | | |
|------------------------------------|--------------------------|------------|
| 1. Public Land Survey | T <u>25N</u> R <u>6E</u> | <u>D-7</u> |
| | T _____ R _____ | _____ |
| | T _____ R _____ | _____ |
| | T _____ R _____ | _____ |
| 2. Property Controlling in Section | S _____ T _____ R _____ | _____ |
| | S _____ T _____ R _____ | _____ |
| 3. Miscellaneous Property in Sec. | S _____ T _____ R _____ | _____ |
| | S _____ T _____ R _____ | _____ |

Alcona County
Remonumentation
Page 11

Date: RECORDED
County Rep: E T L


MAR 10 10 22 AM '95

Doris A. Gauthier
REGISTER OF DEEDS
ALCONA COUNTY, MICHIGAN

Register of Deeds Stamp & File Number

4. Lot No. _____, Recorded Plat _____
5. Private Claims _____

I, Duane R. MacNeill, in a field survey on August 30, 19 94, do hereby certify that under requirements of P.A. 74, Michigan P.A. of 1970, the corner points mentioned in lines 1 and 2 above were in conformance with regulations and rules therefore as required in the current manual of survey instructions of the United States Department of the Interior, Bureau of Land Management or by a decree of a Court of Law and/or that the corner points mentioned in lines 3, 4 and 5 above were in conformance with the rules of the Michigan Board of Land Surveyors or by a Decree of a Court of Law; established, re-established, monumented, re-monumented, recovered, found as expressed below:

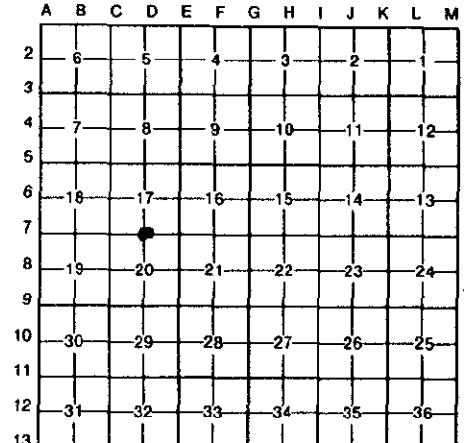

NOTE: Not more than 4 corners, all in the same town and range, may be recorded on this certificate.


A. Description of original monument and accessories and/or subsequent restoration:
1844 - Cedar Post set by Government Surveyor
1990's - No known surveys in this area.

Witnesses:
Beech 9 S28°E 19
Beech 4 N03°W 7

B. Description of corner evidence found and/or method applied in restoring or reestablishing corner:
Set 1/4 corner by G.L.O. proportions between C-7 and E-7 and in Centerline of existing E-W County Road. This checked out reasonably well with doubling the distance between E-7 and the S 1/8 corner of the SE 1/4.

C. Description of monument for corner and accessories established to perpetuate locating the position of the corner:
1994 - Remonumentation Crew set 1/2" re-rod 8" below gravel surface. An Alcona County Brass Cap, appropriately stamped, was secured to the re-rod and witnessed.
Witnesses:
N10°E 25.65 Fence Post
N45°W 47.06 8" Apple
S45°W 49.32 Fence Post
S15°E 32.07 Fence Post

Signed by Duane R. MacNeill
Surveyor's Michigan License No. 19237

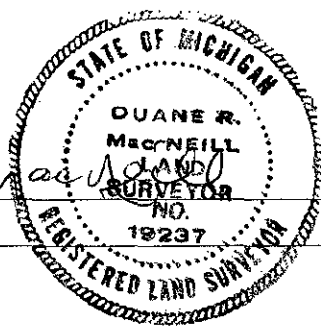

Date December 28, 1994