

1995 Alcona County Remonumentation Corner

Alcona County
Remonumentation
Liber 7 Page 121

LAND CORNER RECORDATION CERTIFICATE
Filing Requirement of Act 74, Mich. P.A. 1970

For corners in Alcona (County) Located In: Corner Code #

RECORDED

- 1. Public Land Survey T 25N R 6E
- T R
- T R
- T R
- 2. Property Controlling S T R
- in Section S T R
- 3. Miscellaneous S T R
- Property in Section S T R

K-5

APPROVED LAND CORNER
P.A. 345 of 1990
ALCONA COUNTY

Date: 7-21-95
County Rep. E.T.L.

JUL 21 2 12 PM '95

Janis A. Smith
REGISTER OF DEEDS
ALCONA COUNTY MICHIGAN

Register of Deeds Stamp & File Number

- 4. Lot No. _____, Recorded Plat _____
- 5. Private Claims _____

A	B	C	D	E	F	G	H	I	J	K
2	6	5	4	3	2					
3										
4	7	8	9	10	11	1				
5										
6	18	17	16	15	14	1				
7										
8	19	20	21	22	23	2				
9										
10	30	29	28	27	26	2				
11										
12	31	32	33	34	35	3				
13										

I, David B. Guthrie in a field survey on May 23, 1995, do hereby certify that under requirements of P.A. 74, Michigan P.A. of 1970, the corner points mentioned in lines 1 and 2 above were in conformance with regulations and rules therefore as required in the current manual of survey instructions of the United States Department of the Interior, Bureau of Land Management or by a decree of a Court of Law and/or that the corner points mentioned in lines 3, 4 and 5 above were in conformance with the rules of the Michigan Board of Professional Surveyors or by a Decree of a Court of Law; established, re-established, monumented, re-monumented, recovered, found as expressed below:

NOTE: Not more than 4 corners, all in the same town and range, may be recorded on this certificate.

- A. Description of original monument and accessories and/or subsequent restoration:
1844: G.L.O. Survey by J.H. Mullett - Set post and referenced Hem. 18 - N39W - 21 / Beech 10 - S28 1/2E - 37
1914: Survey by Andrew J. Freer - Gas pipe 28 in. long.


- B. Description of corner evidence found and/or method applied in restoring or reestablishing corner:
1995: Found P.K. nail over iron stake at the intersection of the east west road and a fenceline to the north.

SURVEY &
REMONUMENTATION

OCT 26 1995

COMMISSION

- C. Description of monument for corner and accessories established to perpetuate locating the position of the corner:
1995: Set a 1/2" x 24" Iron Rod with a brass cap stamped to identify the corner placed in a monument box.
Referenced: North - 3/4" Iron Pipe - 32.70 Feet
 N04°E - Fe. Cor. Post - 37.80 Feet
 N18°W - 8" Maple - 76.45 Feet
 S42°W - 12" Red Pine - 45.75 Feet
 S07°W - 15" White Pine - 93.38 Feet

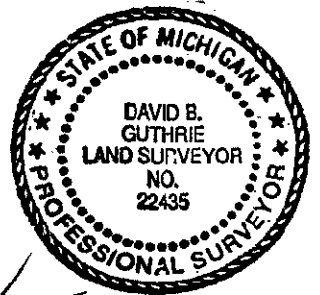

Signed by D.B. Guthrie Date 7/21/95
Surveyor's Michigan License No. 22435